


Section 18 Township 13 Range 14W

Well No. #1 Wenger

Company Emery Concs Co.

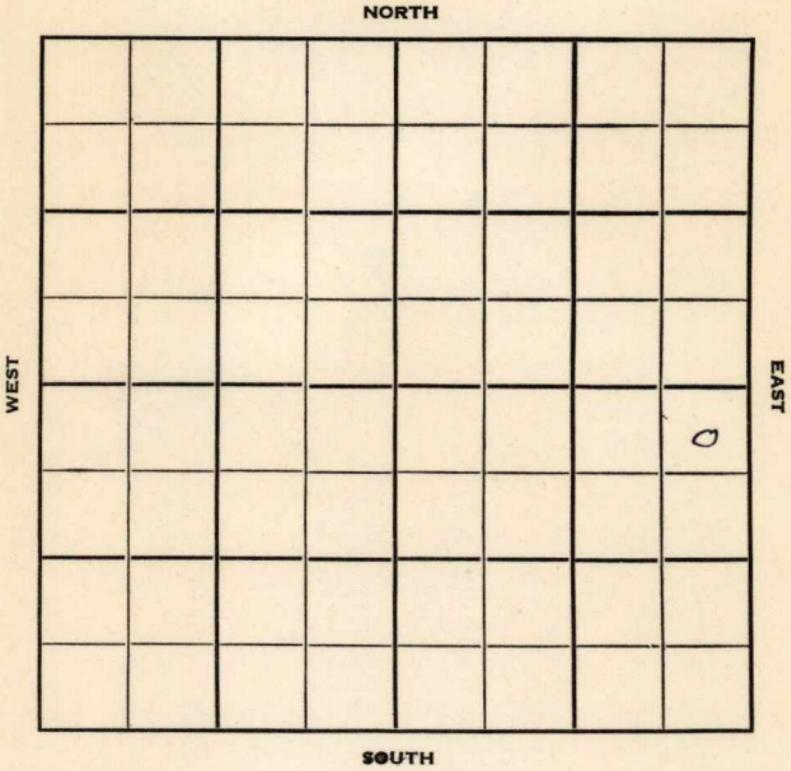

Sec. 18 Twp. 13 R. 14 W

Well No. # 1 Wanger Farm

Emery Conds Co. Company

Stern Contractor


330 Ft. from N. Line

_____ Ft. from S. Line

330 Ft. from E. Line

_____ Ft. from W. Line

NE NE SE

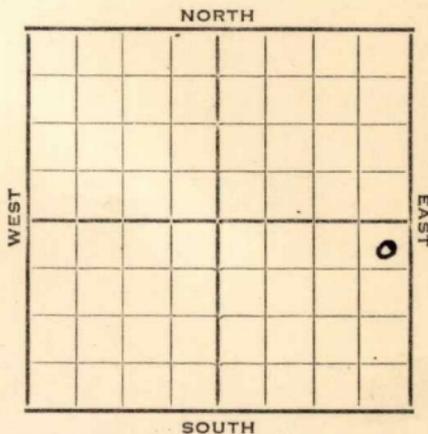

1952

Elev. 1753' REPORT

4/30

8" @ 295'
Anhy 808'
Drlg. 1660'

5/7

Heeb. 2872' **Lans. 2925'**
Drlg. 3021'

5/14

D&A TD 3220
8" @ 295 **Anhy 808 Heeb. 2872**
Lans. 2925
DST 3202-07 opn $\frac{1}{4}$ hr.
No rec. DST 3207-12 opn $\frac{1}{2}$ hr.
No rec. DST 3207-12 opn $1\frac{1}{4}$ hr.
Rec. 18' ocm **Arb. 3196**
DST ? 3220 opn 1 hr. Rec. 450' sw
TD 3220

ABANDONED

County Russell State Kansas

Sec. 18 (Blk. 13 (Sur. 14W (Twp. 13 (Rge. 14W Map No.

Operator Emery Const. Co.

Well No. 1 Farm Wenger

Elev. 1753 Location NE NE SE



330 Ft. From N Line SE

330 Ft. From E Line Quarter

1st. Report

Completion MAY 14 1952

Remarks

Stern Drlg. - Contr.

Spudding Date

Drlg. Data D & A TD 3220

8" @ 295 Anhy 808 Heeb. 2872

Lans. 2925 DST 3202-07 open 1/4 hr.

No rec. DST 3207-12 open 1/2 hr.

No rec. DST 3207-12 open 1 1/4 hr.

Rec. 18' ocm Arb. 3196 DST ? - 3220

open 1 hr. Rec. 450' sw TD 3220

D & A

J. G. McGEHEE