


Section 19 Township 33 Range 3-E

Well No. #1 Heskett et al

Company Ben Gralapp

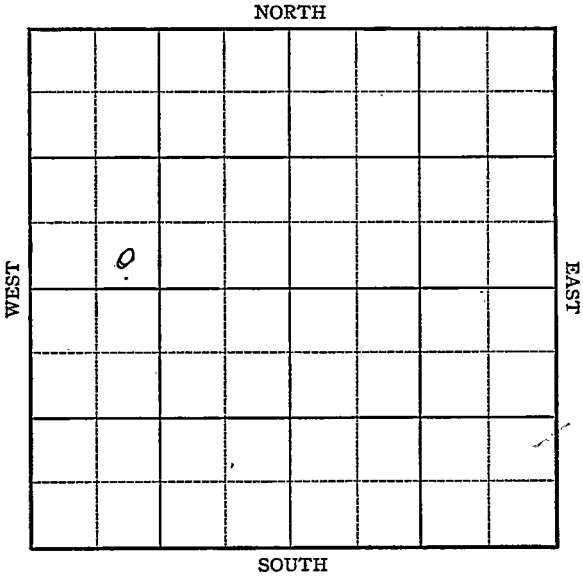

Sec. 19 Twp. 33 R. 3-E

Well No. #1 Heskett et al. Farm


Ben Gralapp Company

 Ft. from N. Line

330 Ft. from S. Line

~~990~~ Ft. from E. Line

990 Ft. from W. Line

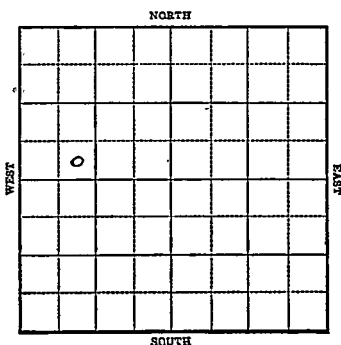

1943

R E P O R T

9/22	Machine	All odd wells plugged
9/29	"	
10/6	20" @ 661 15" @ 627' Drlg. 675'	
10/13	12" @ 1189-	1455 Swedging
10/20	Drlg. 1810'	
10/27	10" @ 1910'	2210' UR 8"
11/3	8" @ 2255 Drlg. 2290'	
11/10	KC 2770 BKC 2895 Aswego 3033 Bart. 3193 Drlg.	
11/17	5" @ 3187 TD 3221	
11/24	40 qts 3216-21-	200' oil
12/1	600' oil 12 hrs TD 3221	
	40 qts 3216-21	200' oil

OVER

1943
12/8

5" @ 3197
Bart 3193
4- qts 3216-21
Pump 78 Pot.
T.D. 3221
Gravity 37

COMPLETED

KANSAS

Map No. 7 Sec. 19 Twp. 33 R. 3E

Well No. I Heskett et al.

Ben Gralapp Company

FIRST REPORT Contractor

SE SW NW check

SECTION PLAT

Ft. from N. Line

330 Ft. from S. Line

990 Ft. from E. Line

990 Ft. from W. Line

Miscellaneous

Location _____

Rig up _____

Drilling and Remarks:

Machine

All old wells plugged

RECORD

Cased _____ in., _____ ft.

Sand _____

Gas _____

Oil _____

Total Depth _____

PRODUCTION

1st 24 hrs. Nat. _____

1st 24 hrs. after shot _____

Gas _____ Cu. Ft.

Dry Hole _____

Abandoned _____

Date

SEP 22 1943 19

S. J. LEWIS Scout

KANSAS

Map No. / Sec. 19 Twp. 33 R. 3E

Well No. 1 Heskett et al.

Ben Gralapp Company

CORRECTION Contractor

SE SW NW

SECTION PLAT

_____ Ft. from N. Line

330 Ft. from S. Line

_____ Ft. from E. Line

990 Ft. from W. Line

Miscellaneous

Location _____

Rig up _____

Drilling and Remarks:

Spotted wrong

RECORD

Cased _____ in., _____ ft.

Sand _____

Gas _____

Oil _____

Total Depth _____

PRODUCTION

1st 24 hrs. Nat. _____

1st 24 hrs. after shot _____

Gas _____ Cu. Ft.

Dry Hole _____

Abandoned _____

Date

SEP 29 1943 19

S. J. LEWIS Scout

KANSAS /
Map No.

Sec. 19

Twp. 33

R. 3E

Well No. 1 Heskett et al.

Ben-Gralepp

Company

COMPLETED

Contractor

SE SW NW

SECTION PLAT

_____ Ft. from N. Line

330

Ft. from S. Line

_____ Ft. from E. Line

990

Ft. from W. Line

Miscellaneous

Location _____

Rig up _____

Drilling and Remarks:

Bar 48193

5" 3197

40 gals 3216-21

Pump 78 8/2

370 1/2

RECORD

Cased _____ in., _____ ft.

Sand _____

Gas _____

Oil _____

Total Depth 3221

PRODUCTION

1st 24 hrs. Nat. _____

1st 24 hrs. after shot _____

Gas _____ Cu. Ft.

Dry Hole _____

Abandoned _____

Date

DEC 8 1943 19

S. I. LEWIS Scout