

KANSAS

Russell County

FORM 51 5M 11-44 PETROL

Section 18 Township 13 Range 14W

Well No. 1 New

Company Bay Pet.

NORTH

		P					

SOUTH

WEST EAST

KANSAS

Russell

Sec. **18** Twp. **13** R. **14W**

Well No. **1 New** Farm

Bay Pet.

Company


Wildcat

330 Ft. from N. Line

Ft. from S. Line

990 Ft. from E. Line

Ft. from W. Line

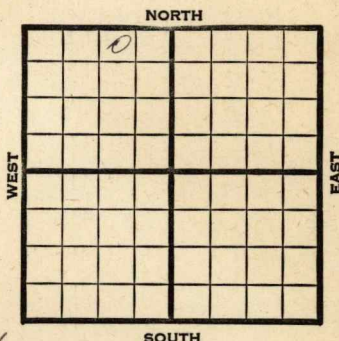

NW NE NW

Elev. 1766

1945

REPORT

6/6	Location
6/14	8" @ 850' WOG
6/21	Dr lg. 2687'
6/28	Lams 2935
	Arb 3194
	TD 3197 SO
	5" @ 3195 RUST
7/3	TD 3197
	1600' fluid in 14 hrs.
7/11	TD 3203'
	500 acid.
	Swab 5 oil per hr.
7/19	" " " " "
7/26	" " " " "
8/1	24 shots on bottom 500 acid.
	Swab 1 oil plus 5 wtr. per hr.
8/8	" " " " "
8/15	" " " " "
8/22	" " " " "
8/29	" " " " "
9/5	" " " " "
9/12	" " " " "
9/19	Arb. 3194
	5" @ 3195
	500 acid.
	TD 3202'
	Pump 215 Pot.
	Grav. 39.0

COMPLETED

Kansas Pool Name WildcatMap No. 72 Sec. 18 Twp. 13 R. 14WWell No. 1 NewBay Pet.


Company

FIRST REPORT

Contractor

NW NE NW

SECTION PLAT

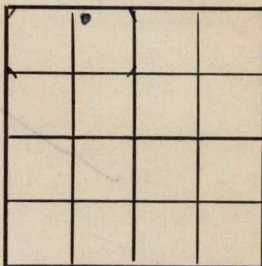330 Ft. from N. Line Ft. from S. Line990 Ft. from E. Line Ft. from W. LineRussell CountyLocation XRig up

Drilling and Remarks:

RECORD

Cased in., ft.Sand Gas Oil Total Depth

PRODUCTION

1st 24 hrs. Nat. 1st 24 hrs. after shot Gas Cu. Ft.Dry Hole Abandoned

Date

JUN 6 1945 19S. J. LEWIS

Scout

KANSAS

Kansas

Pool Name WildcatMap No. 72 Sec. 18 Twp. 13 R. 14WWell No. 1 New

Bay Pet.

Company

COMPLETED

Contractor

NW NE NW

E 11766
SECTION PLAT330 Ft. from N. Line

Ft. from S. Line

990 Ft. from E. Line

Ft. from W. Line

	0		

Russell County

Location

Rig up

Drilling and Remarks:

Cor & 3194
 5" @ 3195
 500 @ acid
 Run 215 ft

39° SW

RECORD

Cased _____ in., _____ ft.

Sand _____

Gas _____

Oil _____

Total Depth 3202

PRODUCTION

1st 24 hrs. Nat. _____

1st 24 hrs. after shot _____

Gas _____ Cu. Ft.

Dry Hole _____

Abandoned _____

Date

SEP 1 9 1945

19

S. J. LEWIS

Scout