


Section 18 Township 13 Range 14W

Well No. 1 New "A"

Company Great Lakes Carbon

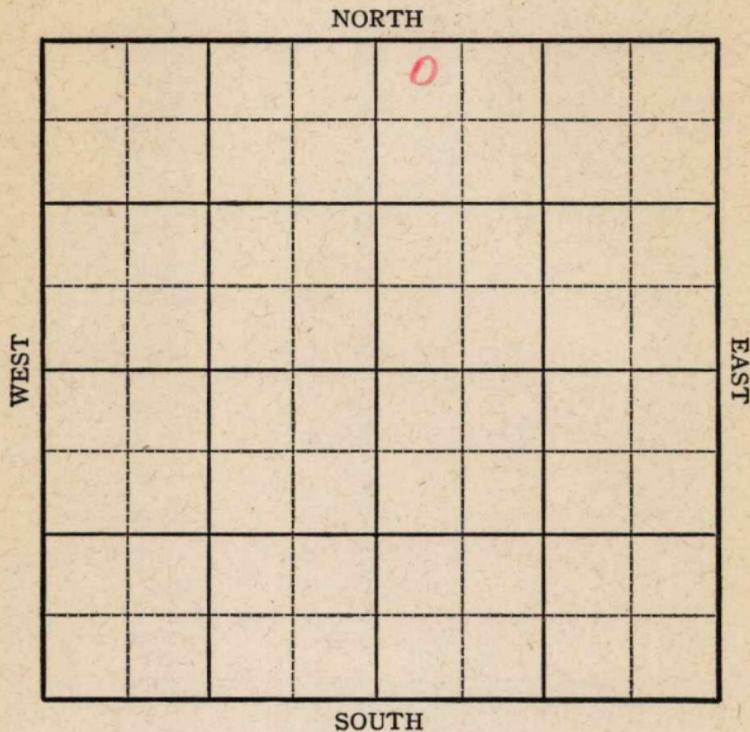

KANSAS

Russell

Sec. 18 Twp. 13 R. 14W

Well No. 1 New "A" Farm

Great Lake Carbon Company

Wildcat


330 Ft. from N. Line

_____ Ft. from S. Line

_____ Ft. from E. Line

330 Ft. from W. Line

NW NE

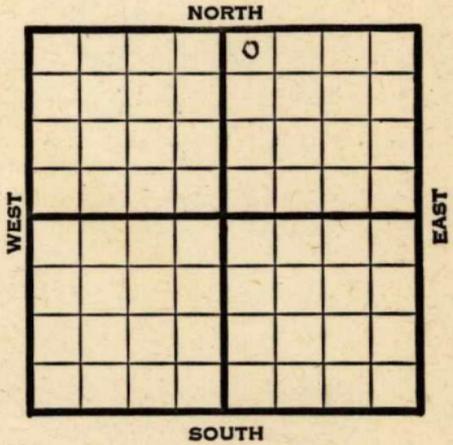

1945

REPORT

Elev. 1719

6/20 10" -408-200 sacks
810'

7/3
Topeka 2566
Lans 2899
Cong 3160
Arb. 3180
TD 3193'

ABANDONED

Kansas Pool Name Wildcat

Map No. 72 Sec. 18 Twp. 13 R. 14W

Well No. 1 New "A"

Great Lakes Carbon Company

FIRST REPORT

Contractor _____

NW NE


SECTION PLAT

330 Ft. from N. Line

_____ Ft. from S. Line

_____ Ft. from E. Line

330 Ft. from W. Line

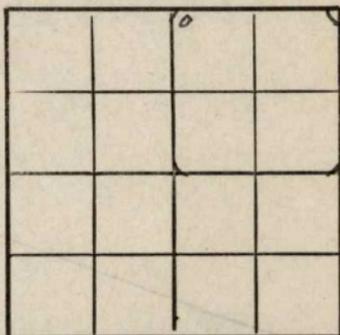

Russell County

Location _____

Rig up _____

Drilling and Remarks:
10"-408-200 sacks
810'

RECORD

Cased _____ in., _____ ft.

Sand _____

Gas _____

Oil _____

Total Depth _____

PRODUCTION

1st 24 hrs. Nat. _____

1st 24 hrs. after shot _____

Gas _____ Cu. Ft.

Dry Hole _____

Abandoned _____

Date

JUN 20 1945 19 _____


S. J. LEWIS Scout

#1 - on this spot
26 this ticket a duplicate
RB

Company _____
Contractor _____

FIRST-REPORT

SECTION PLAT

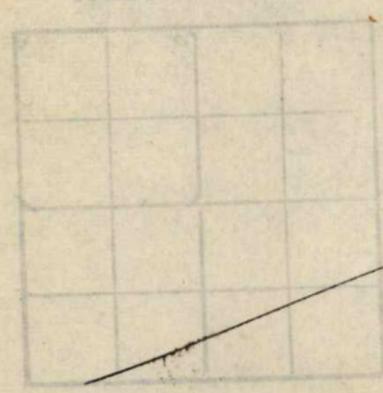

330 Ft. from W. Line
Ft. from S. Line
Ft. from E. Line
330 Ft. from W. Line


RECORD

Case No. _____
Band _____

Location

Rig up

Drilling and Remarks

- Small Maps
- Cards
- Tracing
- France Map
- Scarborough Map
- Pierce Map

Date

Scott _____ JUN 2 0 1935 10

No further report

Map No. _____ Sec. 18 Twp. 18 R. 14W


Well No. _____

Company _____

Contractor _____

ABANDONED

SECTION PLAT

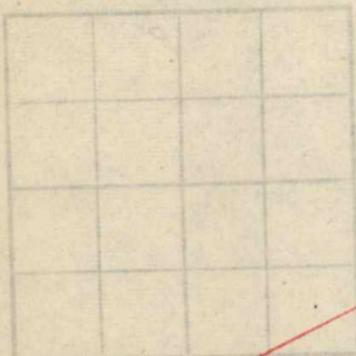

_____ Ft. from N. Line

_____ Ft. from S. Line

_____ Ft. from E. Line

_____ Ft. from W. Line

_____ County

Location _____

Rig up _____

Drilling and Remarks _____

RECORD

Cased _____ in _____

Sand _____

Gas _____

Oil _____

- Small Maps _____
- Cards _____
- Tracing _____
- France Map _____
- Scarborough Map _____
- Pierce Map _____
- Geol. Dept _____

Date _____

1917