

Section 6 Township 17 Range 14WWell No. #1 HejneyCompany Pam - Kar

			0				

NORTH

WEST

EAST

SOUTH

3

Barton KANSAS ✓

Sec. 6 Twp. 17 R. 14 WWell No. # 1 Hejney FarmPam-Kar

Company

Contractor


Wildcat330 Ft. from N. Line

Ft. from S. Line

330 Ft. from E. Line

Ft. from W. Line

NE NE NW

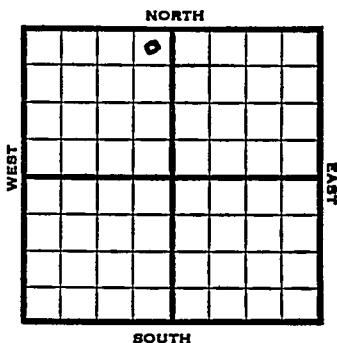

1953 Elev. 1987: REPORT

2/11 ~~2915, 2000~~2/19 (Above information in error)
8" @ 245 Drlg. 700'2/26 Howard 2915, Top 2957, Heeb
3190, Tor 3209, L ans 3258
Drlg. 33513/4 Spud 2-15-53
D&A

TD 3548

8" @ 245

Howard 2915, Top 2957, Heeb
3190, Tor 3209, L ans 3258,
Cong 3480

TD 3548

D&A

ABANDONED

County Barton State KansasSec. 6 (Blk.) 17 - (Sur.) 14W Map No.Operator Pam-KarWell No. 1 Farm HejneyElev. Location NE NE NW

			0			

330 Ft. From N Line NW330 Ft. From E Line Quarter1st. Report FEB 11 1953

Completion

Remarks

Spudding Date

Drlg. Data Wildcatdrlg. 2000

County Barton State KansasSec. 6 (Blk.) 17 (Sur.) 14W Map No.Operator Pam-KarWell No. 1 Farm HejneyElev. 1987 Location NE NE NW

330 Ft. From N Line NW330 Ft. From E Line Quarter

1st. Report

Completion MAR 4 1953Remarks WildcatSpudding Date 2-155-53Drlg. Data D & A TD 35488" @ 245 Howard 2915 Top. 2957Heeb. 3190 Tor. 3209 Lans. 3258Cong. 3480 TD 3548D & A

J. G. McGEHEE