

Russell

FORM 51 IOM 12-46 PETROL

KANSAS

Section 18 Township 13 Range 14-W

Well No. #1 New Estate


Company B & R etal

Russell Pool

NORTH

WEST

EAST

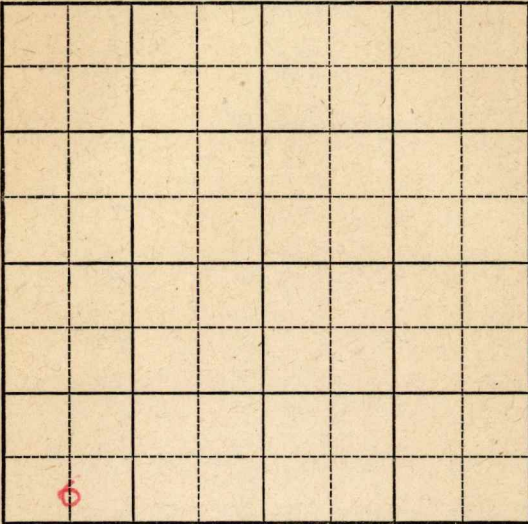

SOUTH

Sec. 18 Twp. 13 R. 14-W

Well No. #1 New Estate Farm

B & R etal. Company

Russell Pool


 Ft. from N. Line

330 Ft. from S. Line

 Ft. from E. Line

660 Ft. from W. Line

C S L SW SW

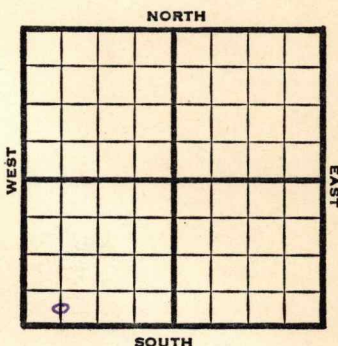

1947

Elev. 1810' REPORT

6/18 Location

6/24 8" @ 553'
WOC

7/1 TD 3279'

7/9 Lans. 2989'
Arb. 3274'
TD 3274'

ABANDONED

Map No. _____ Sec. 18 Twp. 13 R. 14W


Well No. 1 New Estate

B & R etal. Company

FIRST REPORT Contractor

C S L SW SW

SECTION PLAT

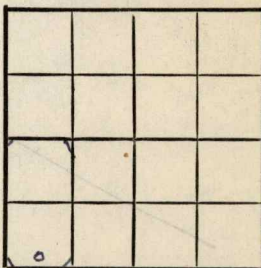

_____ Ft. from N. Line

330 Ft. from S. Line

_____ Ft. from E. Line

660 Ft. from W. Line

Russell County

Location X

Rig up _____

Drilling and Remarks:

RECORD

Cased _____ in., _____ ft.

Sand _____

Gas _____

Oil _____

Total Depth _____

PRODUCTION

1st 24 hrs. Nat. _____

1st 24 hrs. after shot _____

Gas _____ Cu. Ft.

Dry Hole _____

Abandoned _____

Date

JUN 18 1947 19

S. J. LEWIS Scout

Map No. 72 Sec. 18 Twp. 13 R. 14W

Well No. 1 New Estate

B & R et al. Company

ABANDONED

Contractor

C S L SW SW


E 1/8 1/8
SECTION PLAT

 Ft. from N. Line

330 Ft. from S. Line

 Ft. from E. Line

660 Ft. from W. Line

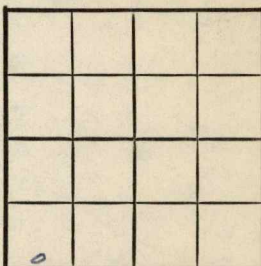

Russell County

Location

Rig up

Drilling and Remarks:

Lam 2885
at 3274

RECORD

Cased in., ft.

Sand

Gas

Oil

Total Depth 3274

PRODUCTION

1st 24 hrs. Nat.

1st 24 hrs. after shot

Gas Cu. Ft.

Dry Hole

Abandoned

Date

JUL 9 1947 19 S. J. LEWIS Scout