


Russell

KANSAS

SECTION 18 TOWNSHIP 13 RANGE 11 W

WELL NO. #1 Wenger

COMPANY Stearns Pet.

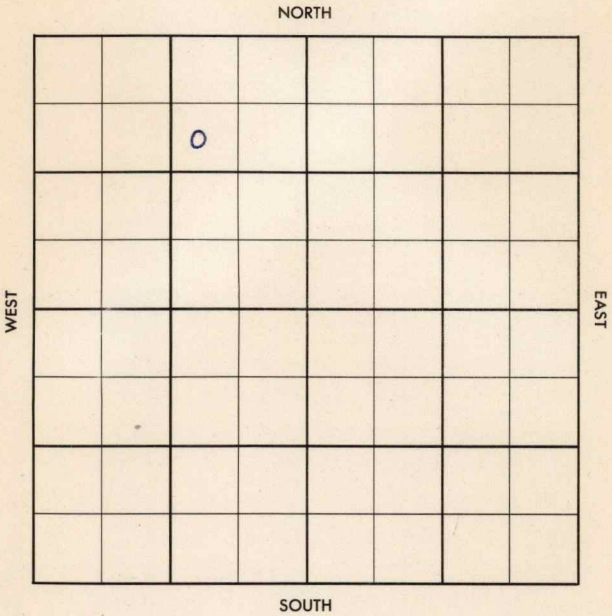

Russell

KANSAS

SEC.	TWP.	R.
18	13	14W

WELL NO.

#1 Wenger

FARM

COMPANY

Stearns Pet.

CONTRACTOR

Co. Tools

N. Atherton


Ft. from N. Line

Ft. from S. Line

Ft. from E. Line

Ft. from W. Line

SW NE NW

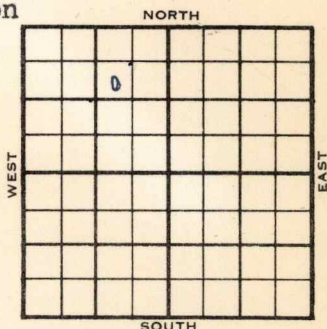

1955

ELEVATION

1694'

REPORT

12-21

Comm. 12-15-55

8" @ 222/125

Drlg. 1876

~~1955~~
1956

1-5

DST 2754-97 op 1 hr. rec. 2150' sw,
1210/20"DST 2868-83 op 1 hr. rec. 10' mud,
35/30"DST 2892-2917 op 2 hrs. rec. 30' gas
30' gco & mud, 70/30"

DST 2942-55 op 1 hr. rec. 300' sw,

DST 3125-29 op 50 min. rec. 8' mud, 0#

DST 3126-38 op $\frac{1}{2}$ hr. rec. 7' mud, 0#DST 3136-53 op $\frac{1}{2}$ hr. rec. 15' mud, 610#

D & A

Tp. 2760

H. 2813

Tr. 2833

L. 2866

A. 3124'

TD 3176'

ABANDONED

County Russell Elev. _____
 Sec. 18 Twp. 13 Rge. 14W
 Company Stearns Pet.
 Farm Name Wenger No. 1

TOPS	DEPTH	LOG	DATUM	Loc. in Sec.
Anh.				SW NE NW
TP.				
H.				
Tr.				
Dg.				
B.L.				
L.				Geol.
K.C.				Contr.
B.K.C.				Co. tools
Ce.				
C.				Pool
M.				N. Atherton
M.				
K.				
Mz.				
Me.				
V.				
S.				
S.				
A.				
R.				
Pc.				
G.				
T.D.				

FIRST REPORT
DEC 27 1968

Date Comm. 12-15-55
8" @ 222/125 drlg. 1876

13

County Russell Elev. 1694
 Sec. 18 Twp. 13 Rge. 14W
 Company Stearns Pet.
 Farm Name Wenger No. 1

TOPS	DEPTH	LOG	DATUM	Loc. in Sec.
Anh.				SW NE NW
Tp.	2760		1066	
H.	2813		1119	
Tr.	2833		1139	
Dg.				
BL.				
L.	2866		1172	Geol.
K.C.				Contr.
B.K.C.				Co. tools
Ce.				
C.				Pool
M.				N. Atherton
M.				
K.				
Mz.				
Ma.				
V.				
S.				
S.				
A.	3124		1430	
R.				
Pe.				
G.				
TD.	3176			

Date Comm. 12-15-55 JAN 5 1956

8" @ 222/125 DST 2754-97 open 1 hr.

rec. 2150' sw 1210/20" DST 2868-83

open 1 hr. rec. 10' mud 35/30"

DST 2892-2917 open 2 hr. rec. 30' gas

30' gco & mud 70/30" DST 2942-55

open 1 hr. rec. 300' sw DST 3125-29

open 50 min. rec. 8' mud Off

DST 3126-38 open $\frac{1}{2}$ hr. rec. 7' mud

ABANDONED

0# DST 3136-53 open $\frac{1}{2}$ hr. rec. 15' mud
610#

D & A

R. G.

JAN 12 1956