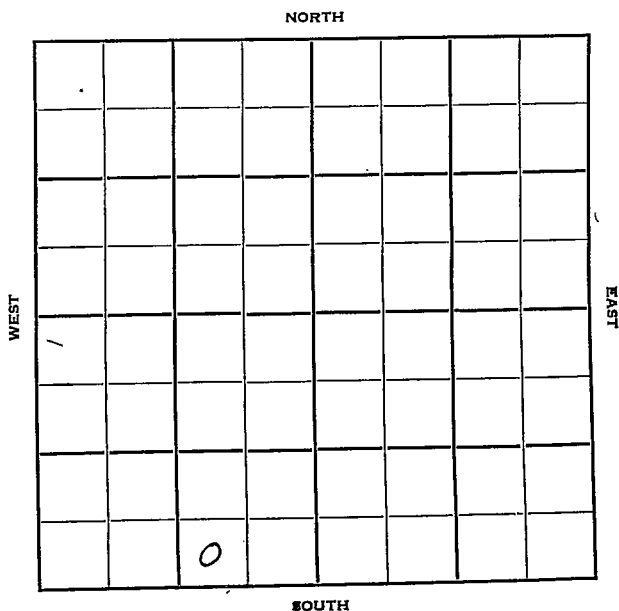


Section 17 Township 21 Range 12WWell No. #5 HeatonCompany Anschutz

Stafford

KANSAS

Sec. 17 Twp. 21 R. 12W ✓

Well No. #5 Heaton Farm

Anschutz

Company

Contractor

Ft. from N. Line

330'


Ft. from S. Line

990'

Ft. from E. Line

Ft. from W. Line

SW SE SW

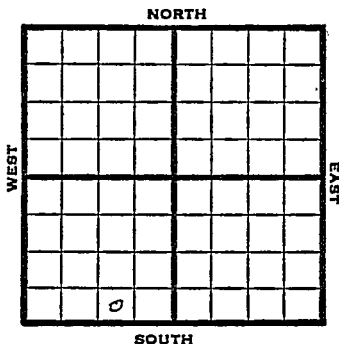

1950

Elev. 1860'

REPORT

4/26

Spud 4-18-50

Drlg. 3090'

5/24

Topeka 2835

Heebner 3117

Br line 3248

Lans 3263

Cong 3487

Simp 3494

Arb 3535

5" @ 3536

TD 3540

comp 157 bopd

Completed

**COMPLETED**

A 23823

Map No. \_\_\_\_\_ Sec. 17 Twp. 21 R. 12WWell No. 5 HeatonAnschutz


Company

Contractor

SW SE SW

E/ 1860

## SECTION PLAT

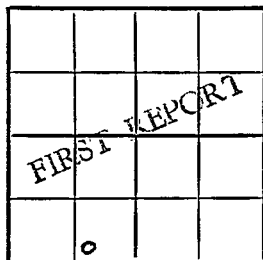

\_\_\_\_\_ Ft. from N. Line

330 Ft. from S. Line990 Ft. from E. Line

\_\_\_\_\_ Ft. from W. Line

Stafford County

Location \_\_\_\_\_

Rig up \_\_\_\_\_

Drilling and Remarks:

Spud 4-18-50

drlg. 3090

## RECORD

Cased \_\_\_\_\_ in., \_\_\_\_\_ ft.

Sand \_\_\_\_\_

Gas \_\_\_\_\_

Oil \_\_\_\_\_

Total Depth \_\_\_\_\_

## PRODUCTION

1st 24 hrs. Nat. \_\_\_\_\_

1st 24 hrs. after shot \_\_\_\_\_

Gas \_\_\_\_\_ Cu. Ft.

Dry Hole \_\_\_\_\_

Abandoned \_\_\_\_\_

Date

APR 26 1950

19

J. E. TYRA

Scout

Kansas

Map No. \_\_\_\_\_ Sec. 17 Twp. 21 R. 12WWell No. 5 HeatonAnschutz Company

Contractor


SW SE SW

E1.1860  
SECTION PLAT

\_\_\_\_\_ Ft. from N. Line

330 Ft. from S. Line990 Ft. from E. Line

\_\_\_\_\_ Ft. from W. Line

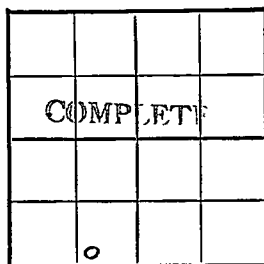

Stafford

Location \_\_\_\_\_

Rig up \_\_\_\_\_

Drilling and Remarks:

*Lopeka* 2835  
*Heebner* 3117  
*Br line* 3248  
*Lane* 3263  
*Cong.* 3487  
*Sing.* 3494  
*arb.* 3535  
*5" @* 3536

## RECORD

Cased \_\_\_\_\_ in., \_\_\_\_\_ ft.

Sand \_\_\_\_\_

Gas \_\_\_\_\_

Oil \_\_\_\_\_

Total Depth \_\_\_\_\_

## PRODUCTION

1st 24 hrs. Nat. \_\_\_\_\_

1st 24 hrs. after shot \_\_\_\_\_

Gas \_\_\_\_\_ Cu. Ft.

Dry Hole \_\_\_\_\_

Abandoned \_\_\_\_\_

Date

MAY 24 1950

19

J. E. TYRA Scout

T.D. 3540

Comp. 157 bopd

|                |       |
|----------------|-------|
| Scout Cards    | ..... |
| Land Small Map | ..... |
| Land Wall Map  | ..... |
| Tracings       | ..... |
| France Map     | ..... |
| Pierce Map     | ..... |
| Misc.          | ..... |

1960

JUN 5

