

Ellis


KANSAS

SECTION 21 TOWNSHIP 13 RANGE 17 W

WELL NO. #1 Hammerschmidt

COMPANY K & E Drlg. & Century Ref.

NORTH

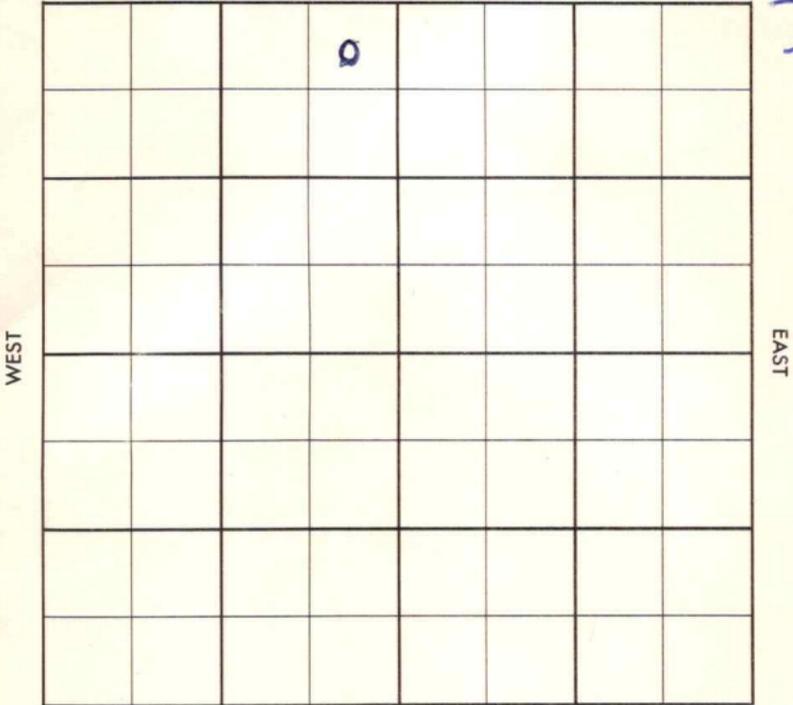

SOUTH

Ellis

KANSAS

SEC. 21	TWP. 13	R. 17W
------------	------------	-----------

WELL NO. #1 Hammerschmidt FARM

COMPANY K & E Drlg. & Century Ref.

CONTRACTOR Co. Tools

Sugar loaf


\_\_\_\_\_ Ft. from N. Line

\_\_\_\_\_ Ft. from S. Line

\_\_\_\_\_ Ft. from E. Line

\_\_\_\_\_ Ft. from W. Line

NE NE NW

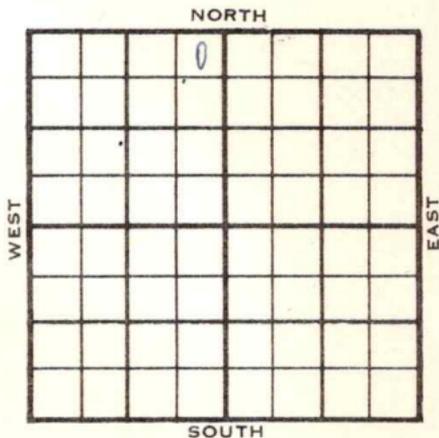

Texas - DHM

1955	ELEVATION 1982	REPORT
------	-------------------	--------

12-21 Comm. 12-18-55  
Rng. surface

1956  
1-5

8 5/8" @ 161  
DST 3316-60 op 1/2 hr. rec. 5' socm, 260#  
DST 3361-3461 op 1 hr. rec. 135' mml, 810#  
D & A  
Anh. 1230  
Tp. 3011  
H. 3255  
Tr. 3276  
L. 3300  
BKC 3593  
C. 3543  
TD 3585

ABANDONED

County Ellis Elev. 1982  
 Sec. 21 Twp. 13 Rge. 17W  
 Company K & B Drlg. & Century Ref.  
 Farm Name Hammerschmidt No. 1

TOPS	DEPTH	LOG	DATUM	Loc. in Sec.
Anh.				NE NE NW
Tp.				
H.				
Tr.				
Dg.				
B.L.				
L.				Geol.
K.C.				Contr.
B.K.C.				Co. tools
Ce.				
C.				Pool
M.				Sugarloaf
M.				<div style="border: 1px dashed black; padding: 5px; text-align: center;">                     FIRST REPORT                      DEC 21 1955                 </div>
K.				
Mz.				
Mq.				
V.				
S.				
S.				
A.				
R.				
Pe.				
G.				
T.D.				

Date Comm. 12-18-55 Texas - DHM  
ing. surface

*[Red scribble]*

Co.  
Lse.  
No.  
Sec.  
T.  
R.

County Ellis Elev. 1982  
 Sec. 21 Twp. 13 Rge. 17W  
 Company K & E Drlg. & Century Ref.  
 Farm Name Hammerschmidt No. 1

TOPS	DEPTH	LOG	DATUM	Loc. in Sec.
Anh.	1230			NE NE NW
TP.	3011		1029	
H.	3255		1275	
Tr.	3270		1294	
Dg.				
BL.				
L.	3300		1318	Geol.
K.C.				Contr.
B.K.C.	3533		1551	Co. tools
Ce.				Pool
C.	3543		1561	Sugarloaf
M.				
M.				
K.				
Mz.				
Mq.				
V.				
S.				
S.				
A.				
R.				
Pe.				
G.				
T.D.	3585			

Date Comm. 12-18-55 JAN 5 1956

8 5/8" @ 161 DST 3316-60 open 1/2 hr.

rec. 5' socm 260# DST 3361-3461

open 1 hr. rec. 135' mw 810#

D & A