

Happer

KANSAS

SECTION 24 TOWNSHIP 31 RANGE 9 W

WELL NO. #2 Darnes Est. "B"

COMPANY O. H. Parker

NORTH

					0		

WEST

EAST

SOUTH

Harper

KANSAS

SEC.	TWP.	R.
24	31	9W

WELL NO.

#2 Darnes Est. "B"

FARM

COMPANY

O.H. Parker

CONTRACTOR

Gabbert-Jones


Grabs

\_\_\_\_\_ Ft. from N. Line

\_\_\_\_\_ Ft. from S. Line

\_\_\_\_\_ Ft. from E. Line

\_\_\_\_\_ Ft. from W. Line

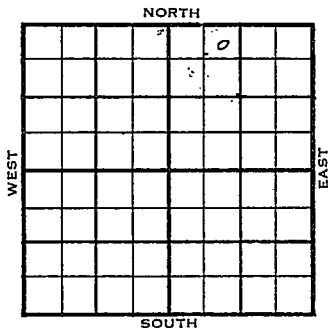

NE NW NE

1955	ELEVATION	REPORT
------	-----------	--------

12-14

Comm. 12-10-55  
8" @ 305/250  
Drig. 1430

County Harper Elev. \_\_\_\_\_  
 Sec. 24 Twp. 31 Rge. 9W  
 Company O. H. Parker  
 Farm Name Darnes Est. "B" No. 2

TOPS	DEPTH	LOG	DATUM	Loc. in Sec.
Anh.				NE NW NE
Ip.				
H.				
Tr.				
Dg.				
Bl.				
L.				Geol. _____
K.C.				Contr. _____
B.K.C.				<b>Gabbert-Jones</b>
Ce.				
C.				Pool _____
M.				<b>Grabs</b>
M.				
K.				
Mz.				
Mo.				
V.				
S.				
S.				
A.				
R.				
PE.				
G.				
T.D.				

0  
 -----  
 FIRST REPORT  
 -----  
 DEC 14 '55

Date Comm. 12-10-55  
8" @ 305/250 drlg. 1430

*[Handwritten signature]*

Co. \_\_\_\_\_  
 Loc. \_\_\_\_\_  
 No. \_\_\_\_\_  
 Sec. \_\_\_\_\_  
 T. \_\_\_\_\_  
 R. \_\_\_\_\_

County Harper Elev. 1593  
 Sec. 24 Twp. 31 Rge. 9W  
 Company O. H. Parker  
 Farm Name Darros Est. "B" No. 2

TOPS	DEPTH	LOG	DATUM	Loc. in Sec.
Asht				NE NW NE
TP				
H.	3405			
Tc				
Dp				
EL				
L.	3606		2013	Geol.
FC				Cont.
MC	4138		2545	Gabbert-Jones
Cc.				Pool
C.	4349		2256	Grabs
M.				
K.				
M.				
M.				
V.				
S.				
S.				
A.				
R.				
PE				COMPLETE
C.				
TR	4450			

Date Comm. 12-10-55 FEB 15 1956

8" @ 305/250 drlg. 1430 DEC 21 55

Ø 4135 DEC 28 55 DST 4349-70  
9 in 2 1/2" 92 1 hr run  
50' OG 6 CM + 130' 654 oil  
BHP 1530/60 DST 4370-90  
9 in 3 1/2" TSTM run 120" run  
420' oil + 90' WT. BHP 1180/20  
5 1/2 4450/ JAN 5 56 20/4385-90  
3 35 B6 + 17 BW 4 hrs 50d

PF 20/4380-85 20/4375-80  
g to s 2 1/2" FU 3000 oil in  
hole 30" T&R JAN 11 '56 P.P

JAN 18 '56 ✓ JAN 25 '56 ✓ FEB 1 '56 P. 68

Bo no/w 8 hrs FEB 8 '56 ✓

FEB 15 '56 Ph P. 111 Bopd 25%

Wtr grav 28°

R.G.

FEB 27 1956