
DX 78-1

Harper KANSAS

Section 24 Township 31 Range 9 W

Well No. # 1 Darnes Est.

Company Berwick Drlg.

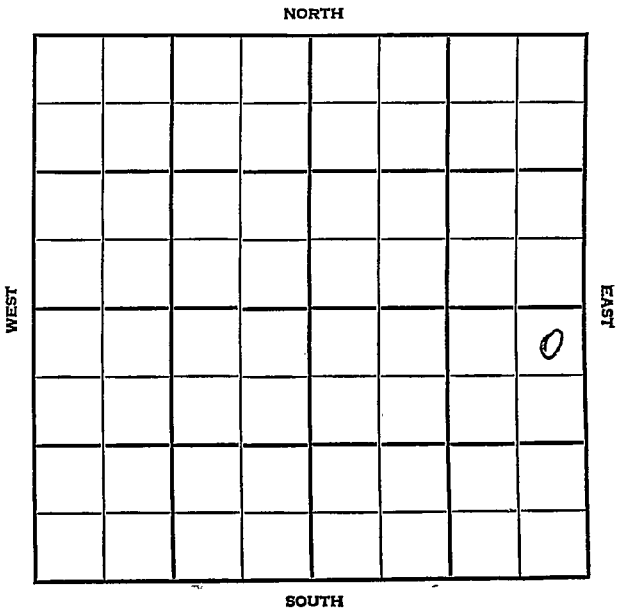

Harper

SEC.	TWP.	R.	KANSAS
24	31	9W	

WELL NO. #1 Darnes Est. FARM

COMPANY Berwick Drlg.

CONTRACTOR Co. Tools.


Grabs Pool

330 Ft. from N. Line

Ft. from S. Line

330 Ft. from E. Line

Ft. from W. Line

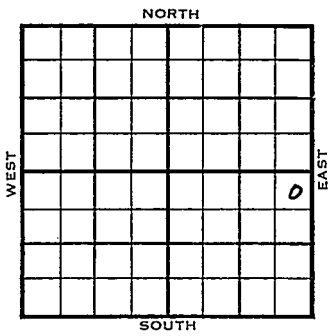

NE NE SE
Carter F/O

1955	ELEVATION 1571	REPORT
3/16	Spud 3-8-55 8-5/8" @ 217' Drlg. 3635'	
8/31	Comm 3/8/55 H 3380 L 3585 Miss 4364 TD 4510 8 5/8" @ 217 w/150 DST 4364-71 open 1 hr. gas to sur 30" Rec 90' ho & gcm BHP 380# 30" DST 4374-84 open 1 hr gas to sur 26" Rec 60' hocm plus 120' free oil 5' wtr BHP 970# 30" FP 0-20# DST 4384-94 open 1 hr Rec 90' ocm 90' muddy wtr BHP 1020# 30" 5" 4500 24/4370-76 250 acid Swb 3 boph 18 hrs went to wtr 48/4390-4402 no tst Sqd all pfs CO 4470 40/4358-68 tst 2 goph frac & R POP Pmp 41½ bo plus 25% wtr 24 hrs Pmp 6½ bopd plus 30% wtr COMPLETED	

DX-78

FORM 275 FOR SALE BY KANSAS BLUE PRINT CO.


County Harper State Kansas

Sec. 24 (Blk. Twp.) 31 (Sur. Rge.) 9W Map No.

Operator Berwick Drlg.

Well No. 1 Farm Darnes Est.

Elev. Location NE NE SE

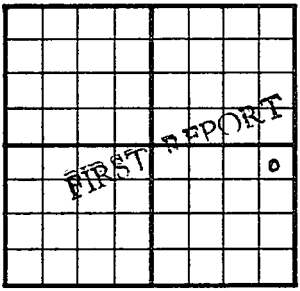

330 Ft. From N Line SE

330 Ft. From E Line Quarter

1st. Report MAR 16 1955

Completion

Remarks Carter farmout
Co. tools

Spudding Date 3-8-55

Drlg. Data Grabs Pool

8 5/8" @ 217 drlg. 3635

FABEN GILSTRAP

FORM 513 REV. SUNRAY

County Harper Elev. 1571

Sec. 24 Twp. 31 Rge. 9W

Company S. A. Berwick Drlg. Co.

Farm Name Barnes Est. No. 1

TOPS	DEPTH	LOG	DATUM
Anh.			
T.P.			
H.	3380		1809
Tr.			
Dg.			
B.L.			
L.	3585		2014
K.C.			
B.K.C.			
Ce.			
C.			
M.			
M./ss	4364		2793
K.			
Mz.			
Mo.			
V.			
S.			
S.			
A			
R.			
P€.			
G.			
T.D.	4510		

Loc. in Sec. NE NE SE

Carter - FO

Geol.

Contr.

Pool

COMPLETE

Date Comm. 3/8/55

AUG 3 1 1955

8 5/8" 217 w/150 DST 4364-71 open 1 hr. gas to sur 30" Rec. 90' ho&gcm BHP 380# 30" DST 4374-84 open 1 hr gas to sur 26" Rec. 60' hocm plus 120' free oil 5' wtr BHP 970# 30" FP 0-20# DST 4384-94 open 1 hr Rec. 90' ocm 90(mdy wtr BHP 1020# 30" 5" 4500 24/4370-76 250 acid Swb 3 bo ph 18 hrs went to wtr. 48/4390-4402 no tst Sqd all FPs CO 4470 40/4358-68 OVER

Co. Lse. No. Sec. T. R.

tst 2 goph frac % & R POP Pmp 41½ bo plus 25% wtr 24 hrs. Pmp 6½ bopd plus 30% wtr

