

KANSAS


Ellis

FORM 51 IOM 12-46 PETROL

Section 21 Township 13 Range 17W

Well No. 2 Dreiling "B"

Company Texas

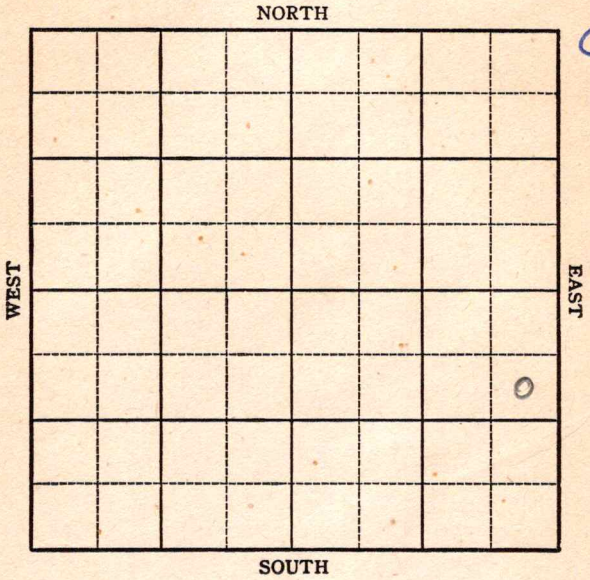

KANSAS

Ellis

Sec. 21 Twp. 13 R. 17-W

Well No. #2 Drilling "B" Farm _____

Texas Company _____


Sugar Loaf Pool

990 Ft. from N. Line

_____ Ft. from S. Line

330 Ft. from E. Line

_____ Ft. from W. Line

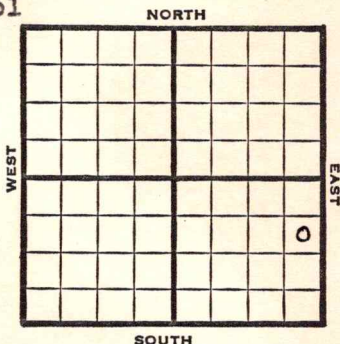

SE NE SE

REPORT

1947 **Elev. 1968'**

5/21 R U R

5/27 8" @ 1210'
Drlg. 2465'

6/3 **Lansing 3276**
Drlg 3478

6/10 **Arbuckle 3518**
5" @ 3522
TD
RUST

6/17 Td 3525
500 acid swt & 6 oil PH

6/24 TD 3635'
1500 Acid
Pump 5 bbls oil PH

7/1 TD 3540'
PB 3537½'
1000 Acid

7/9 **Arb. 3518'**
5" @ 3522'
3000 Acid
pump 202 Pot
27.0 Gr.
TD 3540'

COMPLETED

Kansas

KANSAS Sugar Loaf Pool

Map No. 1571 Sec. 21 Twp. 13 R. 17W

Well No. 2 Dreiling "B"

Texas

Company

FIRST REPORT

Contractor

SE NE SE

SECTION PLAT

990 Ft. from N. Line

_____ Ft. from S. Line

330 Ft. from E. Line

_____ Ft. from W. Line

			o

Ellis County

Location _____

Rig up _____

Drilling and Remarks:

R U R

RECORD

Cased _____ in., _____ ft.

Sand _____

Gas _____

Oil _____

Total Depth _____

PRODUCTION

1st 24 hrs. Nat. _____

1st 24 hrs. after shot _____

Gas _____ Cu. Ft.

Dry Hole _____

Abandoned _____

Date

MAY 21 1947 19

S. J. LEWIS Scout

Map No. 71 Sec. 21 Twp. 13 R. 17W

Well No. 2 Dreiling "B"

Texas

Company _____

COMPLETE

Contractor _____

SE NE SE

E 11968
SECTION PLAT

990 Ft. from N. Line

_____ Ft. from S. Line

330 Ft. from E. Line

_____ Ft. from W. Line

Ellis County

Location _____

Rig up _____

Drilling and Remarks:

*cut 3518
5" @ 3022
3000 acid
Pump 202 *BT**

27° 40'

RECORD

Cased _____ in., _____ ft.

Sand _____

Gas _____

Oil _____

Total Depth 3518

PRODUCTION

1st 24 hrs. Nat. _____

1st 24 hrs. after shot _____

Gas _____ Cu. Ft.

Dry Hole _____

Abandoned _____

Date

JUL 9 1947

19

S. J. LEWIS

Scout