

KANSAS

Ellis

FORM 51 IOM 12-46 PETROL

Section 21 Township 13 Range 17WWell No. 1 Dreiling "C"Company Texas

Sugar Loaf NORTH

							0

WEST EAST

SOUTH

8

KANSAS

Ellis

Sec. 21 Twp. 13 R. 17-W

Well No. #1 Dreiling "C" Farm

Texas Company


 Ft. from N. Line

330 Ft. from S. Line

330 Ft. from E. Line

 Ft. from W. Line

SE NE

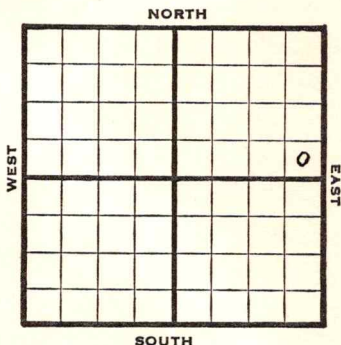

1947

Elev. 1974'

REPORT

4/9

RUR

4/15

8" @ 1220'
Drlg. 2360'

4/23

Lans 3292'
Drlg 3505'

4/29

Arbuckle 3534'
5" @ 3534'
TD 3543'
500 Acid.

5/7

Pump 70 bbls oil in 4 hrs

5/14

Arb. 3534'
5" @ 3534'
500 Acid
Pump 50 Pot
26.7 Gr.
TD 3543'

COMPLETED

Map No. 571 Sec. 21 Twp. 13 R. 17W

Well No. 1 Dreiling "C"

Texas

Company

COMPLETE

Contractor

SE NE


E 41974
SECTION PLAT

 Ft. from N. Line

330 Ft. from S. Line

330 Ft. from E. Line

 Ft. from W. Line

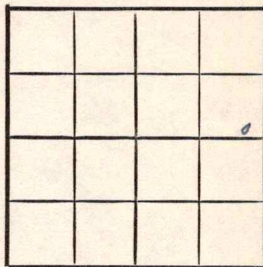

Ellis County

Location

Rig up

Drilling and Remarks:

*Per 43534
5' C 3534.
500 acd
Pump 50 ft*

26 3/4

RECORD

Cased in., ft.

Sand

Gas

Oil

Total Depth 3548

PRODUCTION

1st 24 hrs. Nat.

1st 24 hrs. after shot

Gas Cu. Ft.

Dry Hole

Abandoned

Date

MAY 14 1947

19

S. J. LEWIS

Scout

KANSAS

Map No. K 71 Sec. 21 Twp. 13 R. 17WWell No. 1 Dreiling "C"

Texas


Company

FIRST REPORT

Contractor

SE NE

SECTION PLAT

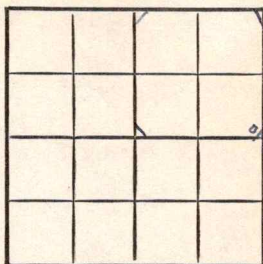

Ft. from N. Line

330

Ft. from S. Line

330

Ft. from E. Line

Ft. from W. Line

Ellis County

Location

Rig up

Drilling and Remarks:

R U R

RECORD

Cased _____ in., _____ ft.

Sand _____

Gas _____

Oil _____

Total Depth _____

PRODUCTION

1st 24 hrs. Nat. _____

1st 24 hrs. after shot _____

Gas _____ Cu. Ft.

Dry Hole _____

Abandoned _____

Date

APR 9 1947

19

S. J. LEWIS

Scout