


KANSAS

Section 21 Township 13 Range 17-W

Well No. #2 Dreiling "C"

Company Texas  
Sugar Loaf

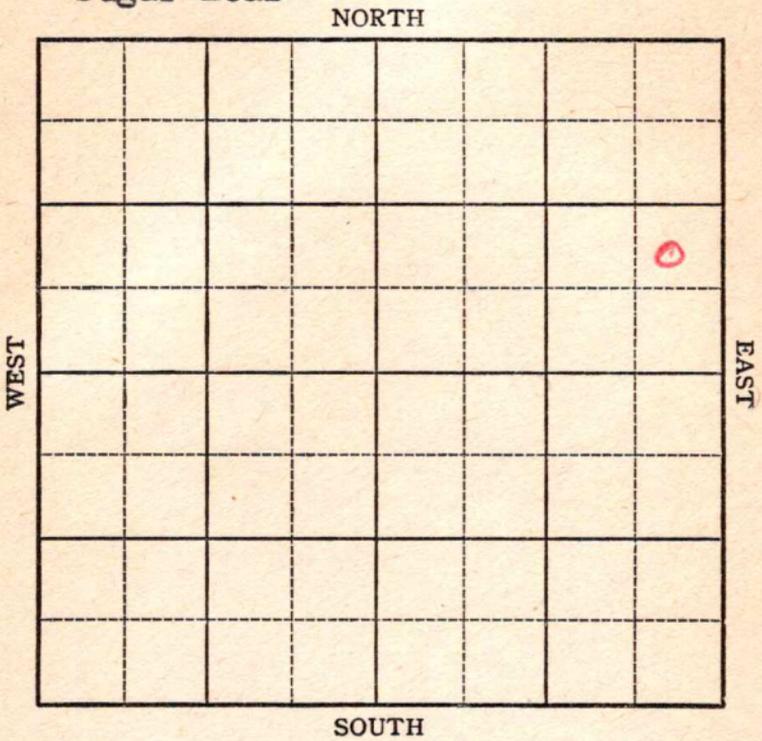

Sec. 21 **KANSAS** Twp. 13 R. 17-W

Well No. # 2 Dreiling "C" Farm \_\_\_\_\_

Texas Company \_\_\_\_\_

**Sugar Loaf Pool**


\_\_\_\_\_ Ft. from N. Line

990 Ft. from S. Line

330 Ft. from E. Line

\_\_\_\_\_ Ft. from W. Line

NE SE NE

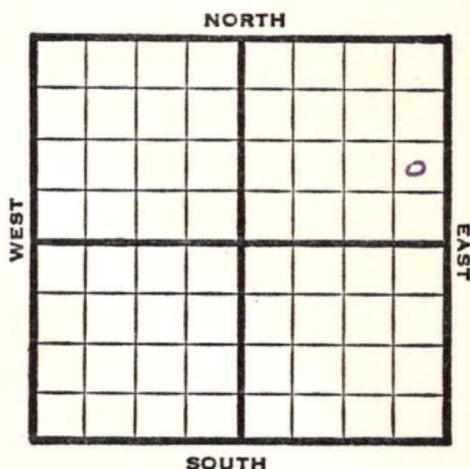

1947

**Elev. 1976'**

REPORT

6/18 R U R

6/24 10" @ 1220'  
Drlg 2135'

7/1 **Lansing 3289'**  
Drgl 3340'

7/8 **Arbuckle 3530'**  
TD 3534'  
5" @ 3531  
300' oil

7-16 Swab 18½ bbls oil PH-8hrs.  
500 Acid

7/22 T.D. 3545'  
Swb 35 bbls oil PH 4 hrs.

7/29 " "

8/6 **Arb. 3530'**  
5" @ 3531'  
Pump 425' Pot.  
Gr. 29  
T.D. 3545'  
Complete

**COMPLETED**

Map No. \_\_\_\_\_ Sec. 21 Twp. 13 R. 17W

Well No. 2 Dreiling "C"

Texas \_\_\_\_\_ Company

FIRST REPORT \_\_\_\_\_ Contractor

NE SE NE

SECTION PLAT

			o

\_\_\_\_\_ Ft. from N. Line

990 Ft. from S. Line

330 Ft. from E. Line

\_\_\_\_\_ Ft. from W. Line

Ellis County

RECORD

Location \_\_\_\_\_

Cased \_\_\_\_\_ in., \_\_\_\_\_ ft.

Rig up \_\_\_\_\_

Sand \_\_\_\_\_

Drilling and Remarks:

Gas \_\_\_\_\_

Oil \_\_\_\_\_

Total Depth \_\_\_\_\_

R U R

PRODUCTION

1st 24 hrs. Nat. \_\_\_\_\_

1st 24 hrs. after shot \_\_\_\_\_

Gas \_\_\_\_\_ Cu. Ft.

Dry Hole \_\_\_\_\_

Abandoned \_\_\_\_\_

Date

JUN 1 8 1947 19 \_\_\_\_\_

S. J. LEWIS Scout

Kansas Sugar Loaf Pool

Map No. 71 Sec. 21 Twp. 13 R. 17W

Well No. 2 Dreiling "C"

Texas

Company

COMPLETE

Contractor

NE SE NE

*E1, 1976*  
SECTION PLAT

\_\_\_\_\_ Ft. from N. Line

990 Ft. from S. Line

330 Ft. from E. Line

\_\_\_\_\_ Ft. from W. Line

			3

Ellis County

Location \_\_\_\_\_

Rig up \_\_\_\_\_

Drilling and Remarks:

*AY 8580*

*5' C 3531*

*Pay 425.00*

*29° SW*

RECORD

Cased \_\_\_\_\_ in., \_\_\_\_\_ ft.

Sand \_\_\_\_\_

Gas \_\_\_\_\_

Oil \_\_\_\_\_

Total Depth 9545

PRODUCTION

1st 24 hrs. Nat. \_\_\_\_\_

1st 24 hrs. after shot \_\_\_\_\_

Gas \_\_\_\_\_ Cu. Ft.

Dry Hole \_\_\_\_\_

Abandoned \_\_\_\_\_

Date

AUG 6 1947 19

S. J. LEWIS Scout