
FORM 51 25M 3-49 PETROL /Russell KANSAS

Section 19 Township 13 Range 14W

Well No. #4 Deines

Company Emry Construction Co.

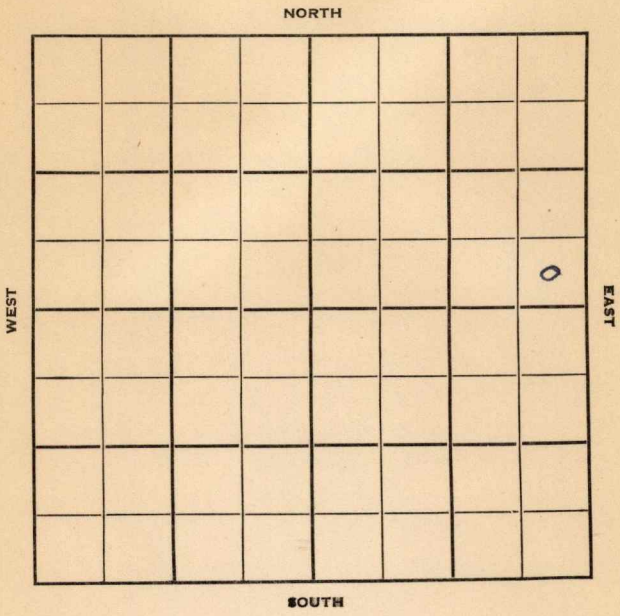

FORM 252-B Russell KANSAS

Sec. 19 Twp. 13 R. 14W

Well No. #4 Deines Farm

Emery Construction Co. Company

Contractor

Atherton Pool


____ Ft. from N. Line

330 Ft. from S. Line

330 Ft. from E. Line

____ Ft. from W. Line

NE¼ SE SE NE

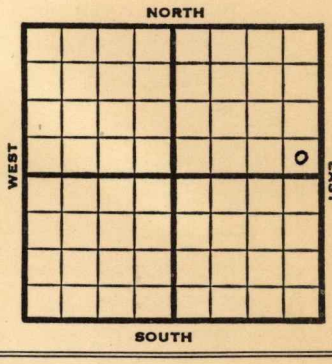

1952	REPORT
	Elev. 1840'
11/5	Spud 10-31-52 8" @ 211' Drlg. 1980'
11/12	Heeb. 2961 Lans. 3013 Drlg. 3065'
11/19	Spud 10-31-52 D & A TD 3310' 8" @ 211 Heeb 2961' Lans. 3013' Arb. 3280' TD 3310' 5" @ 3309 CO to 3300 16/3284-96 HFW DST 3282-89 open 1½ hr. rec 8' SOCM D & A ABANDONED

FORM 275 FOR SALE BY KANSAS BLUE PRINT CO.


County Russell State Kansas

Sec. 19 (Blk. Twp.) 13 (Sur. Rge.) 14W Map No.

Operator Emery Construction Co.

Well No. 4 Farm Deines

Elev. Location SE SE NE

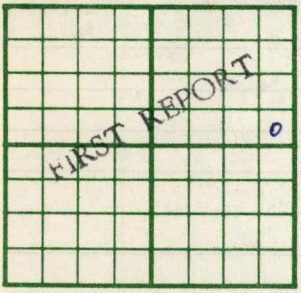

330 Ft. From S Line NE

330 Ft. From E Line Quarter

1st. Report NOV 5 1952

Completion

Remarks

Spudding Date 10-31-52

Drlg. Data Atherton Pool

8" @ 211 drlg. 1980

J. G. McGEHEE

FORM 275 FOR SALE BY KANSAS BLUE PRINT CO.


County Russell State Kansas

Sec. 19 (Blk. Twp.) 13 (Sur. Rge.) 14W Map No.

Operator Emery Construction Co.

Well No. 4 Farm Deines

Elev. 1840 Location SE SE NE

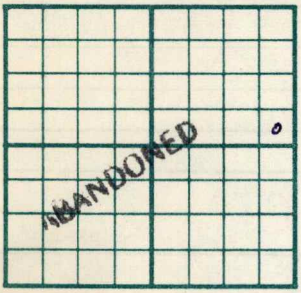

330 Ft. From S Line NE

330 Ft. From E Line Quarter

1st. Report

Completion NOV 19 1952

Remarks Atherton Pool

Spudding Date 10-31-52

Drlg. Data D & A TD 3310

8" @ 211 Heeb. 2961 Lans. 3013 Arb.

Arb. 3280 TD 3310 5" @ 3309 CO to 3300

16/ 3284-96 HFW DST 3282-89 open 1½ hr

Rec. 8' socm

D & A

J. G. McGEHEE