

Stafford


KANSAS

DX 78-1

Section 2 Township 21 Range 11 W

Well No. #1 Birbeck

Company Wilcox, Henry, Durbin Bond & Lewis

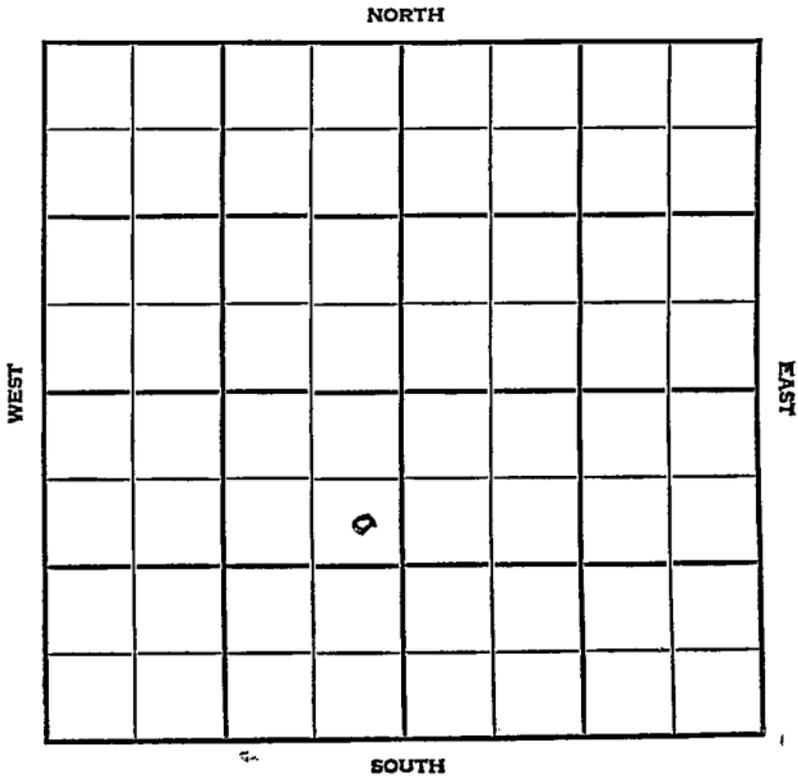





County Stafford Elev. 1920  
 Sec. 2 Twp. 21 Rge. 14W  
 Company Wilcox, Henry, Durbin Bond & Lewis  
 Farm Name Birbeck No. 1

TOPS	DEPTH	LOG	DATUM	Loc. in Sec.
Anh.				SE NE SW
Tr.				
H.	<u>3218</u>			
Tr.				
Dg.				
Bl.	<u>3331</u>			
L.	<u>3342</u>			
K.C.				Geol.
B.K.C.	<u>3556</u>			Contr.
Ce.				Lewis
C.				
M.				Pool
M.				
K.				
Mz.				
Ma.				
V.	<u>3570</u>			<div style="border: 1px solid black; padding: 5px; text-align: center;"> <p><b>COMPLETE</b></p> <p>ex</p> <p>JUN 13 '56</p> </div>
S.	<u>3593</u>			
S.				
A.	<u>3636</u>			
R.				
PE.				
G.				
TD.	<u>3642</u>			

Date Comm. 3-13-56  
8 5/8" @ 800/425 DST 3459-72 open 52 min  
rec. 360' gas 180' ho & gcm 180' mud  
DST 3475-89 open 1 hr. rec. 30' socm  
30' wm DST 3492-3505 open 1 hr.  
rec. 10' mud Off DST 3510-46  
open 1 hr. rec. 48' mud Off  
DST 3580-99 open 1 hr. rec. 5' mud  
Off DST 3637-42 open 1 hr.

**OVER**

rec. - 750' oil CI100# 5 1/2" @ 3637

CO to 3642 FU 2200' oil 3 hr.

S/ 10 bopd 1 hr. P/ 20 bopd

Comp. 20 bopd 100 bw

*[Handwritten signature]*  
958

JUN 25 1966