


DX 78-1 Ellis

KANSAS

Section 21 Township 13 Range 17W

Well No. #1 Jacobs "A"

Company Sterling Drlg et al

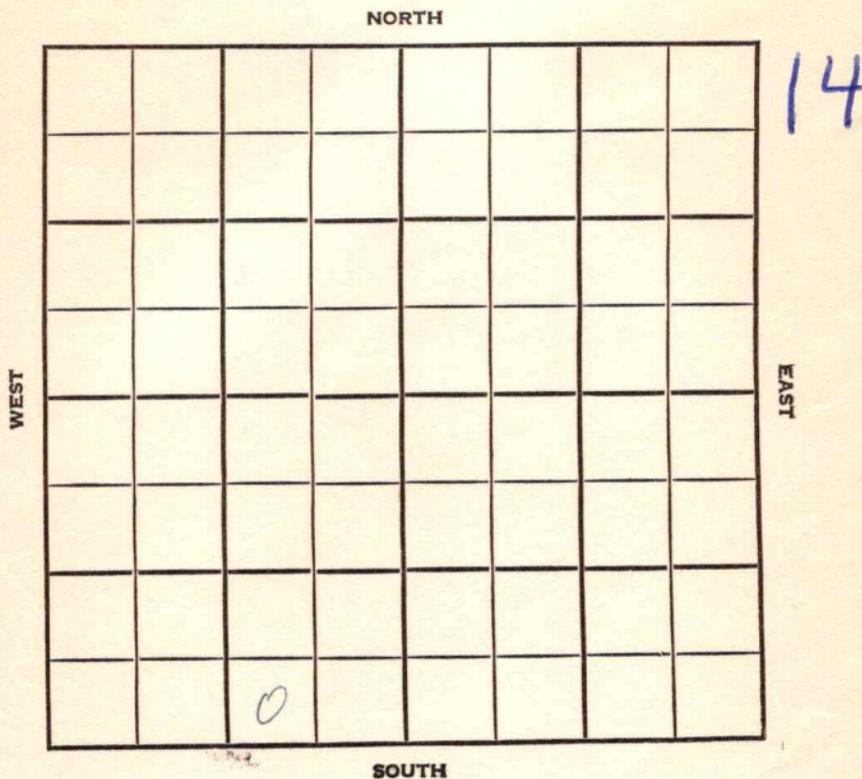

County Ellis Elev. _____
 Sec. 21 Twp. 13 Rge. 17W
 Company Sterling Drig. etal.
 Farm Name Jacobs "A" No. 1

TOPS	DEPTH	LOG	DATUM	Loc. in Sec.
Anh.				SW SE SW
Tp.				
H.				
Tr.				
Dg.				
Bl.				
L.				Geol. _____
K.C.				Contr. _____
B.K.C.				
Ce.				Co. tools
C.				
M.				Pool
M.				SE Sugarloaf
K.				
Mz.				
Me.				
V.				
S.				
S.				
A.				
R.				
Pe.				
G.				
T.D.				

FIRST REPORT

0

Date Comm. M I R AUG 15 '56

AUG 5 1956

14

2

Co.
Lse.
No.
Sec.
T.
R.

County Ellis Elev. 1788
 Sec. 21 Twp. 13 Rge. 17W
 Company Sterling Drig. etal.
 Farm Name Jacobs "A" No. 1

TOPS	DEPTH	LOG	DATUM	Loc. in Sec.
Anh.				SW SE SW
Tr.				
H.	3228			
Tr.				
Dg.				
Bl.				
L.	3273			Geol.
K.C.				
B.K.C.				Contr.
Ce.				
C.	3520			Co. tools
M.				
M.				Pool
K.				SE Sugarloaf
Mz.				
Ma.				
V.				
S.				
S.				
A.				
R.				
Pe.				
G.				
T.D.	3590			

ABANDONED

Date Comm. AUG 29 1956
M I R AUG 22 '56 8-14-56 85/8

200/135 @ 2765 AUG 29 '56
DST 3275-3310 @ 70" 15' Md
BHP 625/30" DST 3310-60 l/m
at 150' M E SW 500/15" DST
3362-80 @ 1/m. 90' SW BHP
0

D & W