

Company Gulf


KANSAS

Ellis



Sec. 21 Twp. 13 R. 17W

Well No. #2 Leo Farm

Gulf Company

Catherine


990 Ft. from N. Line

 Ft. from S. Line

330 Ft. from E. Line

 Ft. from W. Line

SE NE NE

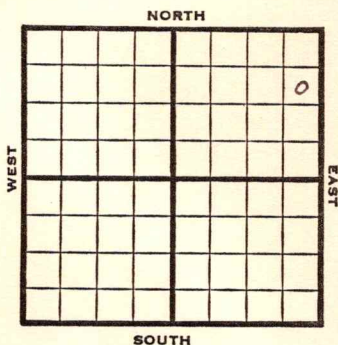

1947

Elev. 1978' REPORT

8/27
9/3

Location
"

9/10

8" @ 1218
WOC

9/17

Arbuckle 3530'
TD 3535'
Run 5"

9/24 n

Lansing 3207'
5" @ 3 533'

10/1

TD 3546'
1000 acid.

10/8

"

10/15

"

10/22

Arbuckle 3530'
5" @ 3533'
1000 Acid
Pump 427 Pot
Gr. 27°
Total Depth 3546'
COMPLETED

Map No. _____ Sec. 21 Twp. 13 R. 17W

Well No. 2 Leo

Gulf Company

FIRST REPORT Contractor

SE NE NE


SECTION PLAT

990 Ft. from N. Line

_____ Ft. from S. Line

330 Ft. from E. Line

_____ Ft. from W. Line

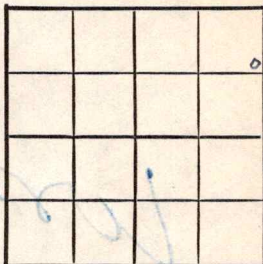

Ellis County

Location X

Rig up _____

Drilling and Remarks:

RECORD

Cased _____ in., _____ ft.

Sand _____

Gas _____

Oil _____

Total Depth _____

PRODUCTION

1st 24 hrs. Nat. _____

1st 24 hrs. after shot _____

Gas _____ Cu. Ft.

Dry Hole _____

Abandoned _____

Date

AUG 27 1947 19 S. J. LEWIS Scout

Catherine Pool

Map No. 71 Sec. 21 Twp. 13 R. 17W

Well No. 2 Leo

Gulf

Company

COMPLETE

Contractor

SE NE NE

E. 1978
SECTION PLAT

990 Ft. from N. Line

_____ Ft. from S. Line

330 Ft. from E. Line

_____ Ft. from W. Line

Ellis County

Location _____

Rig up _____

Drilling and Remarks:

Cur 3530
5' @ 3533
1000 sand
Prod. 4-27-58
27-5-58

RECORD

Cased _____ in. _____ ft.

Sand _____

Gas _____

Oil _____

Total Depth 3546

PRODUCTION

1st 24 hrs. Nat. _____

1st 24 hrs. after shot _____

Gas _____ Cu. Ft.

Dry Hole _____

Abandoned _____

Date

OCT 22 1947 19

S. J. LEWIS Scout