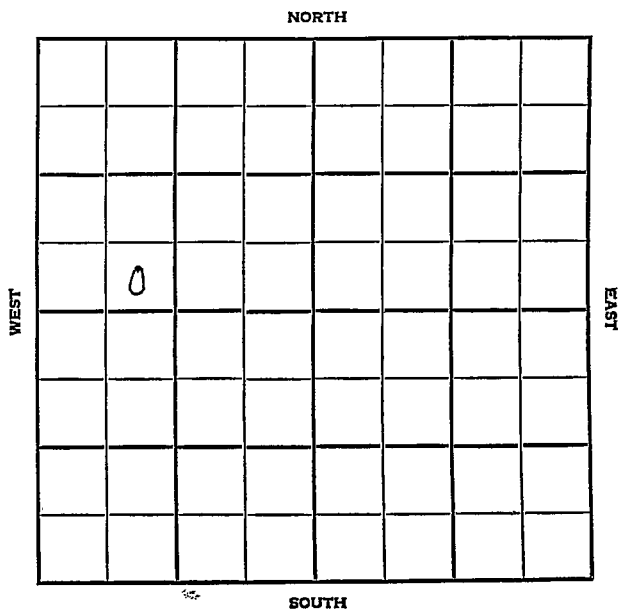


Section 15 Township 21 Range 14 WWell No. #1 TaylorCompany Eldorado Ref.

LOT FILE		Stafford	KANSAS
SEC. 4	11	11	R.
15	21	14 W	

WELL NO.

1 Taylor

FARM

COMPANY

ElDorado Ref.

CONTRACTOR


Sterling
Taylor

_____ Ft. from N. Line

_____ Ft. from S. Line

_____ Ft. from E. Line

_____ Ft. from W. Line

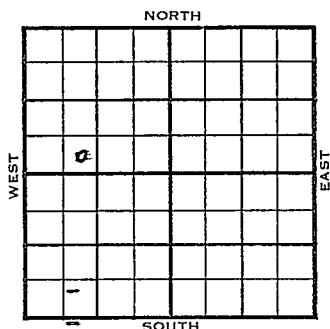

SE SW NW

1/2 Mile - SDX Lse

	ELEVATION	REPORT
1955	1933'	
8/24	Comm. 8-18-55 8" @ 260/200 Drlg. 2200' Anhy 870'	
XXX 9-2	Heeb. 3259, Tor. 3283, Doug. 3300, Br.lime 3376, Lans. 3386, Cong. 3637, Viola 3642, Simp. 3691, Lans. 3386 Cong. 3637 , Arb. 3741, T.D. 3755, DST 3503-55, open $\frac{1}{2}$ hr. rec. 45' mud, $\frac{1}{2}$ DST 3636-57, open $\frac{1}{2}$ hr., rec 5' mud, 0# DST 3667-3718, open 1 hr., rec. 960' fluid, 970/20",	
9-8	TD 3755, 5 $\frac{1}{2}$ " @ 3755, CO to 3730, 33/ 3711-15, FU 500' oil 20 min., 1000' oil in 2 hr., S/37.54 bo in 5 hr. FU 725' oil 24 hr., 725' oil end of 40 hr., waiting on orders	
9-15	FU 969' oil in 64 hr., S/ 1.66 boph for 18 hrs., 500 A, frac S/ 11.7 bo in 12hr	
9-22	No report	
9-29	Pmp 25 bo plus 4% wtr. 24 hrs.	

1955

10/5

Comm 8-18-55
8" @ 260/200

Anh	870	
H	3259-	3261
Tr	3283	3289
Dg	3300	
Bl	3376	3379
L	3386	3390
BKC		3625
C	3637	3637
V	3642	3645
S	3691	3695
A	3741	3743
TD	3755	

DST 3503-55 open 1/2 hr Rec 45' mud

DST 3636-57 open 1/2 hr Rec 5' mud

O# DST 3667-3718 open 1 hr Rec 960'

fluid 970/20" TD 3755 5 1/2" @

3755/100 CO to 3730 33/3711-15

FU 500' oil 20 min FU 1000' oil 2 hr

S/37.54 bo 5 hr FU 725 ~~mx~~ oil 24 hr

969' oil 64 hr S/1.66 boph 18 hr

500 A frac S/11.7 BO 12 hr P/25 BO

4% wtr. Comp 32 bopd 3% wtr.

COMPLETED

County Starford

Elev. _____

Sec. 25 Twp. 21Rge. 11WCompany El Dorado Ref.Farm Name TaylorNo. 1

TOPS	DEPTH	LOG	DATUM
Anh.	870		
Tr.			
H.			
Tr.			
Dg.			
BL.			
L.			
K.C.			
B.K.C.			
Ce.			
C.			
M.			
M.			
K.			
Mz.			
Mq.			
V.			
S.			
S.			
A.			
R.			
PE.			
G.			
TD.			

Loc. in Sec. _____

SE SW 1/4

Geol. _____

Contr. _____

Sterling

Pool _____

Taylor

<u>1/2</u>	<u>13</u>	<u>55</u>
<u>0</u>	<u>24</u>	<u>55</u>
FIRST REPORT		

Date Comm. 8-18-558" @ 260/200 drlg. 2200

County Stafford Elev. 1933
 Sec. 15 Twp. 21 Rge. 11W
 Company El Dorado Ref.
 Farm Name Taylor No. 1

TOPS	DEPTH	LOG	DATUM	Loc. in Sec.
Anh.	870			SE SW NW
Tr.				
H.	3259	3261	1328	
Tr.	3283	3289	1356	
Dg.	3300			
Bl.	3376	3379	1446	
L.	3386	3390	1457	Geol.
K.C.				Contr.
B.K.C.		3625	1692	
Ce.				
C.	3637	3637	1704	Sterling
M.				Pool
M.				
K.				
Mz.				Taylor
Mq.				
V.	3642	3645	1712	
S.	3691	3695	1762	
S.				
A.	3741	3743	1810	
R.				
P.E.				
G.				
T.D.	3755			

COMPLETE

Date Comm. 8-18-55 OCT 5 1955

8" @ 260/200 DST 3503-55 open $\frac{1}{2}$ hr.

Rec. 45' mud DST 3636-57 open $\frac{1}{2}$ hr.

Rec. 5' mud ... 0# ... DST 3667-3718

open 1 hr. Rec. 960' fluid ... 970/20"

TD 3755 5 $\frac{1}{2}$ " @ 3755/100 CO to 3730


33/ 3711-15 FU 500' oil 20 min.

FU 1000' oil 2 hr. S/ 37.54 bo 5 hr.

FU 725' oil 24 hr. 969' oil 64 hr.

OVER

S/ 1.66 boph 18 hr. 500 A frac
S/ 11.7 bo 12 hr. P/ 25 bo 4% wtr.
Comp. 32.bopd 3% wtr.

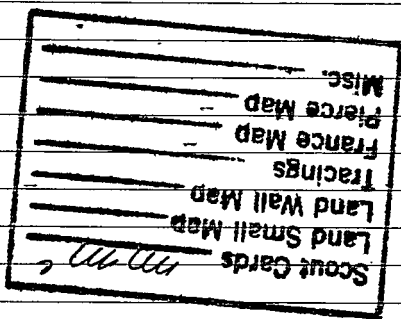

OCT 14 1955