


Section 22 Township 13 Range 17-W

Well No. #3 Dreiling

Company Cities Service

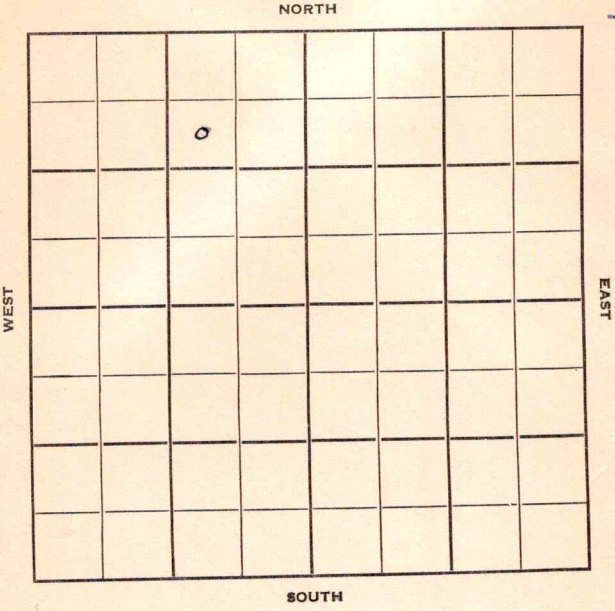

Ellis
13

KANSAS
17W

Sec. 22 Twp. 13 R. 17W

Well No. #3 Dreiling Farm

Cities Service Company

Catherine Pool Contractor


990' Ft. from N. Line

_____ Ft. from S. Line

990' Ft. from E. Line

_____ Ft. from W. Line

SW NE NW

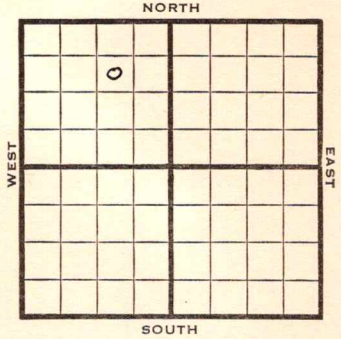

1950

Elev 2004

REPORT

6/28

Location

8/16

8" @ 1245

Lans 3309

Arb 3552

TD 3557

5" @ 3546

CO to 3552

FU 1350' oil 1/2 hr 1910' oil 2 hr

Comp 3000 bopd

Completed

COMPLETED

Map No. _____ Sec. 22 Twp. 13 R. 17W

Well No. 3 Dreiling

Cities Service Company

Contractor

SW NE NW

SECTION PLAT

990 Ft. from N. Line

_____ Ft. from S. Line

990 Ft. from E. Line

_____ Ft. from W. Line

	0		

FIRST REPORT

Ellis County

Location X

Rig up _____

Drilling and Remarks:

RECORD

Cased _____ in., _____ ft.

Sand _____

Gas _____

Oil _____

Total Depth _____

PRODUCTION

1st 24 hrs. Nat. _____

1st 24 hrs. after shot _____

Gas _____ Cu. Ft.

Dry Hole _____

Abandoned _____

Date

JUN 28 1950 19

J. E. TYRA Scout

County Ellis State Kansas

Sec. 22 (Blk. 13 (Sur. 17W Map No.
(Twp.) (Rge.)

Operator Cities Service

Well No. 3 Farm Dreiling

Elev. 2004 Location SW NE NW

	0				
COMPLETE					

990 Ft. From N Line NW

990 Ft. From E Line Quarter

1st. Report

Completion AUG 16 1950

Remarks

Catherine Pool

Spudding Date

Drlg. Data Oil well TD 3557

8" @ 1245 Lans. 3309 Arb. 3552

TD 3557 5" @ 3546 CO to 3552

FU 1350' oil $\frac{1}{2}$ hr. 1910' oil 2 hr.

Comp. 3000 bopd

J. E. TYRA