

Ellis

KANSAS

Section 22 Township 13 Range 17 W

Well No. # 2 L. J. Dreiling (D)

Company Texas Co.

NORTH

WEST

			0				

EAST

SOUTH

17



Sec. 22 Twp. 13 R. 17 W

Well No. # 2 L. J. Dreiling (D) Farm

Texas Co.

Company

Wakefield

Contractor

330

Ft. from N. Line


Ft. from S. Line

330

Ft. from E. Line

Ft. from W. Line

NE NE SW

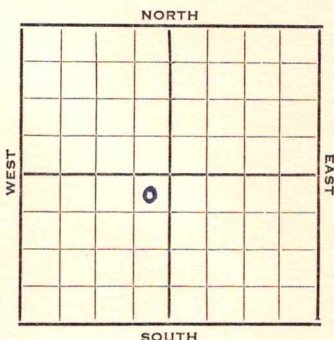

1952 Elev. 2000' REPORT

9/10 MM MIR

9/17 8" @ 1235'
Drlg. 2685'

9/24 Topeka 3024' Heeb 3264' Lans. 3313'
DST 3388-3410, 1 hr, 10' M 840#
Arb. 3550' TD 3560' 5" @ 3585'

10/1 CO 3560 4 galoph DD 3562 DD 3565
12 galoph DD 3569 TD 15 galoph 500A
1½ BOPH 1500A S/3½ BOPH for 8 hrs.

10/15 Spud 9-9-52
Oil Well TD 3569'
8" @ 1235' Top. 3024 Heeb. 3264
Lans. 3313
DST 3388-3410 open 1 hr. rec. 10' mud
840#
Arb. 3550 TD 3560 5" @ 3555
CO to 3560 4 goph DD 3562
DD 3565 12 goph DD 3569
15 goph 500 A 1½ boph 1500 A
3½ boph 8 hr. Comp. 168 bopd
36 bw

COMPLETED

County Ellis State KansasSec. 22 (Blk.) 13 (Sur.) 17W Map No.Operator Texas Co.Well No. 2 Farm L. J. Dreiling (D)Elev. Location NE NE SW

330 Ft. From N Line SW330 Ft. From E Line Quarter1st. Report SEP 10 1952

Completion

Remarks

Wakefield - Contr.

Spudding Date

Drlg. Data

MIR

J. G. McGEHEE

