


DX 78-1 ELLIS

KANSAS

Section 22 Township 13 Range 17W

Well No. 3 Rome

Company Brooks Pierce et al

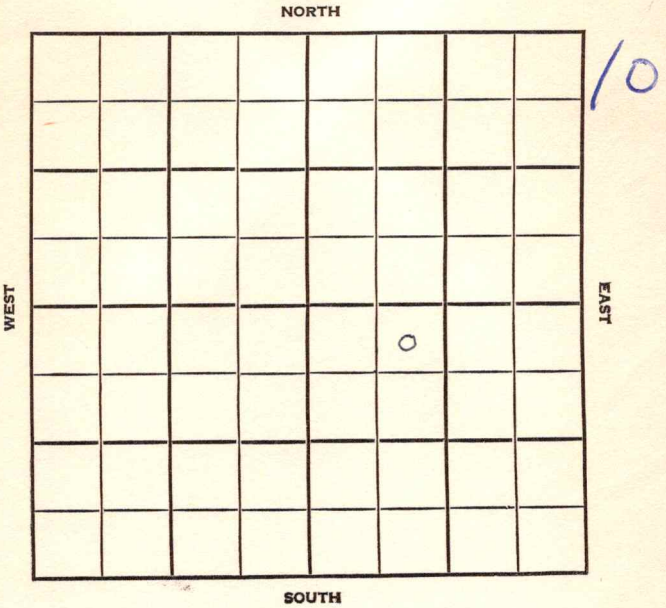


SEC. 22 TWP. 13 R. 17 W

WELL NO. # 3 Rome FARM

COMPANY Brooks Pierce et al

CONTRACTOR

330 Ft. from N. Line
 Ft. from S. Line
 Ft. from E. Line
 990 Ft. from W. Line

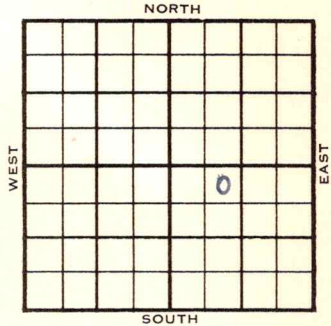

NE NW SE

1955 ELEVATION 1992' REPORT

3/30
 4/13

Location
 Spud 3-29-55 D & A TD 3598
 8" @ 123 Anhy 1210 Heeb 3243
 KC 3287
 DST 3290-3320 open 1/2 hr rec 82' mud
 420# Cong. 3537 TD 3598
 D & A
ABANDONED

