

KANSAS

FORM 51 IOM 12-46 PETROL

Ellis

Section 22 Township ¹³~~15~~ Range 17W

Well No. 1 Rome "B"

Company Cities Service

No Name NORTH

WEST EAST

SOUTH

12

0

KANSAS

Ellis

Sec. 22 Twp. 13 ~~15~~ R. 17 ~~W~~

Well No. #1 Rome "B" Farm

Cities Service

Company


990 Ft. from N. Line

Ft. from S. Line

Ft. from E. Line

330 Ft. from W. Line

SW NW SW

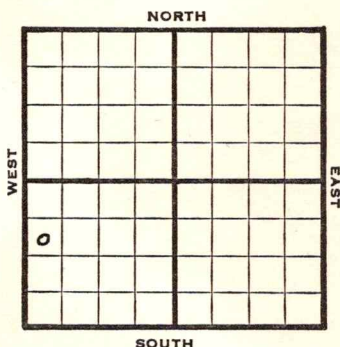

1947 **Elev. 1983'** REPORT

4/9 8" set 1212'
Dr1g. 1410'

4/15 **Arbuckle 3536-37' TD**
5" @ 3536'
RUST

4/23 **SLM 3537--3527**
Arb 3526
5" @ 3526
TD 3531'
2350' oil in 4 $\frac{1}{4}$ hrs

4/29 500 Acid
Pump 307 bbls. oil 24 hrs.

5/7 1000 Acid

5/14 **Arb. 3526'**
5" @ 3526'
2000 Acid
Pump 451 Pot
28.0 Gr.
TD 3536'

COMPLETED

KANSAS

Map No. 574 Sec. 22 Twp. 15 R. 17W

Well No. 1 Rome "B"

Cities Service

Company

FIRST REPORT

Contractor

SW NW SW


SECTION PLAT

990 Ft. from N. Line

 Ft. from S. Line

 Ft. from E. Line

330 Ft. from W. Line

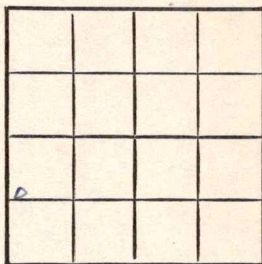

Ellis County

Location

Rig up

Drilling and Remarks:

8" @ 1212.

drlg. 1410

RECORD

Cased in., ft.

Sand

Gas

Oil

Total Depth

PRODUCTION

1st 24 hrs. Nat.

1st 24 hrs. after shot

Gas Cu. Ft.

Dry Hole

Abandoned

Date

APR 9 1947

19

S. J. LEWIS

Scout

Map No. 1574 Sec. 22 Twp. 13 R. 17W

Well No. 1 Rome "B"

Cities Service Company

CORRECTION Contractor

SW NW SW

990 Ft. from N. Line

 Ft. from S. Line

 Ft. from E. Line

330 Ft. from W. Line

SECTION PLAT

0			

Ellis County

Location

Rig up

Drilling and Remarks:

Reported

22-15-17W

RECORD

Cased in., ft.

Sand

Gas

Oil

Total Depth

PRODUCTION

1st 24 hrs. Nat.

1st 24 hrs. after shot

Gas Cu. Ft.

Dry Hole

Abandoned

Date

APR 16 1947

19

S. J. LEWIS

Scout

Kansas

Sugar Loaf Pool

Map No. 571 Sec. 22 Twp. 13 R. 17WWell No. 1 Rome "B"


Cities Service

Company

COMPLETE

Contractor

SW NW SW

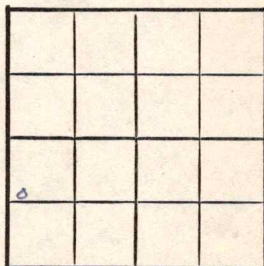E. 1974
SECTION PLAT990 Ft. from N. Line Ft. from S. Line Ft. from E. Line330 Ft. from W. Line

Ellis County

Location Rig up

Drilling and Remarks:

Cut 35265" @ 35262000 acidPump 451 BX2826

RECORD

Cased in., ft.Sand Gas Oil Total Depth 3526

PRODUCTION

1st 24 hrs. Nat. 1st 24 hrs. after shot Gas Cu. Ft.Dry Hole Abandoned

Date

MAY 14 1947

19

S. J. LEWIS

Scout