


Ellis county

Section 22 Township 13 Range 17-W

Well No. #1, L. Von Lintel

Company The Texas Company

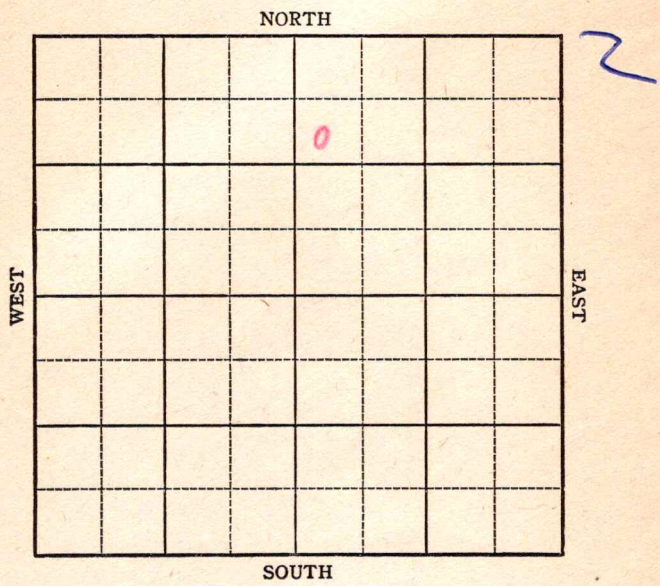

KANSAS

Ellis county ✓

Sec. 22 Twp. 13 R. 17-W

Well No. #1, L. Von Lintel Farm

The Texas Company Company

Sugar Loaf Pool

990'


Ft. from N. Line

Ft. from S. Line

Ft. from E. Line

330'

Ft. from W. Line

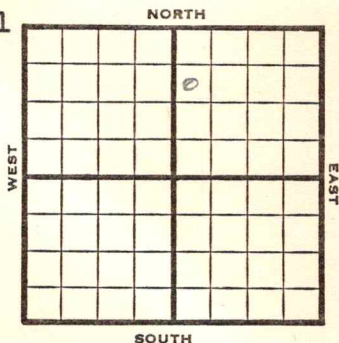

SW NW NE

1946

Elev. 1991'

REPORT

12/11

Location

12/17

Anhy 1190-

8" @ 1209 WOC

1947

Lans 3298'

Cong 3560'

Arb 3574'

TD 3652'

1/2

ABANDONED

KANSAS
Kansas

Sugar Loaf Pool

Map No. 71 Sec. 22 Twp. 13 R. 17WWell No. 1 L. Von LintelTexas


Company

FIRST REPORT

Contractor

SW NW NE

SECTION PLAT

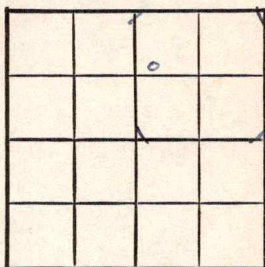990 Ft. from N. Line Ft. from S. Line Ft. from E. Line330 Ft. from W. Line

Ellis County

Location XRig up

Drilling and Remarks:

RECORD

Cased in., ft.Sand Gas Oil Total Depth

PRODUCTION

1st 24 hrs. Nat. 1st 24 hrs. after shot Gas Cu. Ft.Dry Hole Abandoned

Date

DEC 1 1 1946 19S. J. LEWIS Scout

Kansas

Map No. 71 Sec. 22 Twp. 13 R. 17WWell No. 1 L. Von Lintel

Texas

Company

ABANDONED

Contractor

SW NW NE

*E1199***SECTION PLAT**

990 Ft. from N. Line Ft. from S. Line Ft. from E. Line330 Ft. from W. Line

Ellis County

RECORDLocation Cased in., ft.Rig up Sand

Drilling and Remarks:

Gas Oil Total Depth 8652**PRODUCTION**1st 24 hrs. Nat. 1st 24 hrs. after shot Gas Cu. Ft.Dry Hole Abandoned

Date

JAN 2 1947 19**S. J. LEWIS**

Scout

Lans 8298
Coig 8560
Art 83574