

Rush

KANSAS

6

17

20W

SECTION _____ TOWNSHIP _____ RANGE _____

WELL NO. #1 Noble

COMPANY Helmerich & Payne

NORTH

						0	

9

WEST

EAST

SOUTH

Rush

KANSAS


SEC.	TWP.	R.
6	17	20W

WELL NO. #1 Noble FARM

COMPANY Helmerich & Payne

CONTRACTOR Peel Bros.
Wildcat

_____ FT. FROM N. LINE
 _____ FT. FROM S. LINE
 _____ FT. FROM E. LINE
 _____ FT. FROM W. LINE

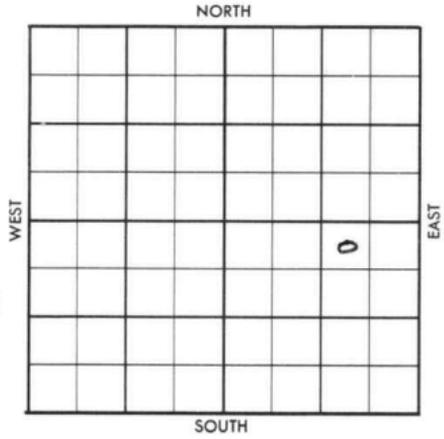

NW NE SE

1956	ELEVATION	REPORT
------	-----------	--------

9-12
 Comm 9-10-56
 8" @ 293/200
 Drlg 293

County Rush Elev. _____
 Sec. 6 Twp. 17 Rgs. 20W
 Company Helmerich & Payne
 Farm Name Noble No. 1

Co.

TOPS	DEPTH	LOG	DATUM
Anh.			
TP.			
H.			
Tr.			
Dg.			
Bl.			
L.			
K.C.			
B.K.C.			
Ce.			
C.			
M.			
M.			
K.			
Mz.			
Me.			
V.			
S.			
S.			
A			
R.			
PE.			
G.			
T.D.			

Loc. in Sec. NW NE SE

Geol. _____

Contr. _____

Peel Bros.
~~Pool DOWNEN Pool~~
~~Wildcat~~

FIRST REPORT
 SEP 12 '56

Use

No.

Sec.

T.

R.

Date Comm. 9-10-56

8" @ 293/200 drlg. 293

293-1-293

293-1-293

County Rush Elev. 2156
 Sec. 6 Twp. 17 Rge. 20W
 Company Helmerich & Payne
 Farm Name Noble No. 1

TOPS	DEPTH	LOG	DATUM	Loc. in Sec.
Anh.				NW NE SE
TP.				
H.	3522	3527		
Tr.	3543	3547		
Dg.				
Bl.				
L.	3556	3566		
K.C.				Geol.
B.K.C.	3834	3839		Contr.
Ce. <u>56</u>	3980	3985	sh. 6' 25'	Peel Bros.
C. <u>esd</u>		3997-4040		Pool
M.				Wildcat
M.				
K.				
Mz.				
Mo.				
V.		4045		
S.				
S.				
A	4111	4116		
R.				
PE.				
G.				
TD.	4126			

ABANDONED
 SEP 26 '56

Date Comm. 9-10-56

8" @ 293/200 drlg. 293 SEP 19 '56 # 3640

SEP 26 '56 DST 3983-4036 1hr

see 90' city wty md BHP
 1100/20" Log

D90