

KANSAS

FORM 51 IOM 12-46 PETROL

Russell County

Section 19 Township 13 Range 14-W

Well No. ✓ 1 Gayno


Company B & R Drlg.

Russell Pool

NORTH

WEST

EAST

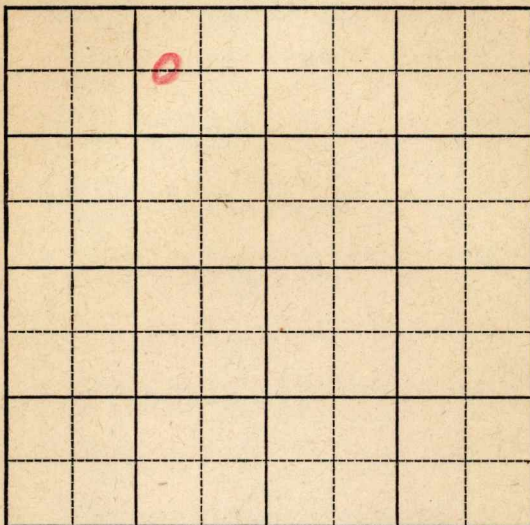

SOUTH

Russell

KANSAS

Sec. 19 Twp. 13 R. 14-W

Well No. #1 Gayno Farm

B & R Drlg Company

Russell

660

Ft. from N. Line


Ft. from S. Line

990

Ft. from E. Line

Ft. from W. Line

C W L NE NW

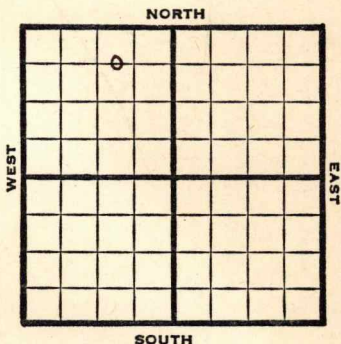

1947

Elev. 1740'

REPORT

7/1

R U R

7/8

8" @ 500

Drlg 1430'

7-16

Lansing 2900

BKC 3138

Drlg. 8187

7/22

TD 3200'

5" @ 3000'

RUST

7/29

"

8/6

Lans 2900'

5" @ 3000'

T.D. 3200'

Abandoned

ABANDONED

Map No. _____ Sec. 19 Twp. 13 R. 14W

Well No. 1 Gayno

B & R Drlg.

Company

FIRST REPORT

Contractor

C W L NE NW

SECTION PLAT

660 Ft. from N. Line

_____ Ft. from S. Line

990 Ft. from E. Line

_____ Ft. from W. Line

Russell County

Location _____

Rig up _____

Drilling and Remarks:

R U R

RECORD

Cased _____ in., _____ ft.

Sand _____

Gas _____

Oil _____

Total Depth _____

PRODUCTION

1st 24 hrs. Nat. _____

1st 24 hrs. after shot _____

Gas _____ Cu. Ft.

Dry Hole _____

Abandoned _____

Date

JUL 2 1947 19

S. J. LEWIS

Scout

Russell Pool

Map No. 72 Sec. 19 Twp. 13 R. 14W

Well No. 1 Gaynor

B & R Drlg.

Company

ABANDONED

Contractor

C W L NE NW

E 11740
SECTION PLAT

660 Ft. from N. Line

_____ Ft. from S. Line

990 Ft. from E. Line

_____ Ft. from W. Line

	0		

Russell County

Location

Rig up

Drilling and Remarks:

Loss 2800
5' C 3000

RECORD

Cased _____ in., _____ ft.

Sand _____

Gas _____

Oil _____

Total Depth 3200

PRODUCTION

1st 24 hrs. Nat. _____

1st 24 hrs. after shot _____

Gas _____ Cu. Ft.

Dry Hole _____

Abandoned _____

Date

AUG 6 1947 19

S. J. LEWIS Scout

Map No. _____ Sec. 19 Twp. 13 R. 14W

Well No. 2 Gaynor

B & R Drlg.

Company

CORRECTION

Contractor

C W L NE NW

correct well name

SECTION PLAT

660 Ft. from N. Line

_____ Ft. from S. Line

990 Ft. from E. Line

_____ Ft. from W. Line

now in files

Russell County

Location

Rig up

Drilling and Remarks

Completed
8/6/47 as
#1 Gaynor

RECORD

Cased _____ in., _____ ft.

Sand _____

Gas _____

Oil _____

Total Depth _____

PRODUCTION

1st 24 hrs. Nat. _____

1st 24 hrs. after shot _____

Gas _____ Cu. Ft.

Dry Hole _____

Abandoned _____

Date

JAN 26 1949 19

S. J. LEWIS

Scout