

Russell


KANSAS

FORM 51 IOM 12-46 PETROL

Section 19 Township 13 Range 14W

Well No. ~~#1~~ #1
~~1~~ Gaynor

Company B & R et al

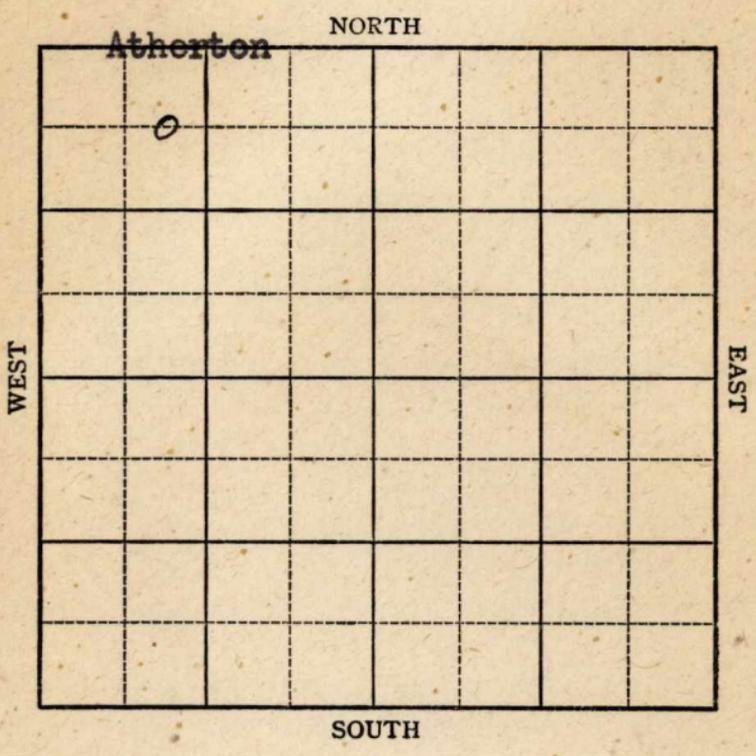

KANSAS

Russell ✓

Sec. 19 Twp. 13 R. 14W

Well No. ~~1~~ 1 Gaynor Farm

B & R etal Company

Atherton


660 Ft. from N. Line

Ft. from S. Line

Ft. from E. Line

990

Ft. from W. Line

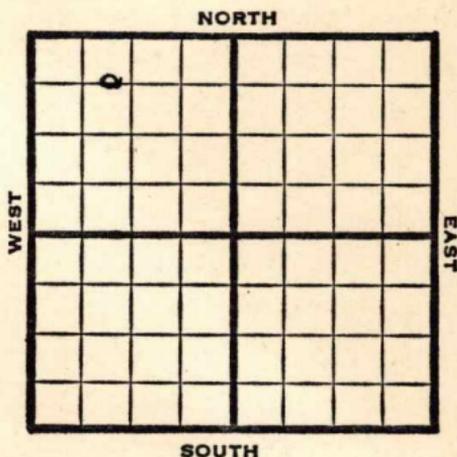

C E L NW NW

1947

Elev. 1806' REPORT

4/30 Location

5/7 Surface Hole

5/13 8" @ 350'
Drlg. 2175'

5/20 " "

5/27 " "

6/3 " "

6/10 " "

6/18 **Arb. 3241'**
5" @ 3241'
1000 Acid
Pump 63 Pot
39.0 Gr.
TD 3246'

COMPLETED

Map No. 72 Sec. 19 Twp. 13 R. 14W

Well No. 1 Gaynor

B & R etal. Company

FIRST REPORT Contractor

C E L NW NW


SECTION PLAT

660 Ft. from N. Line

_____ Ft. from S. Line

_____ Ft. from E. Line

990 Ft. from W. Line

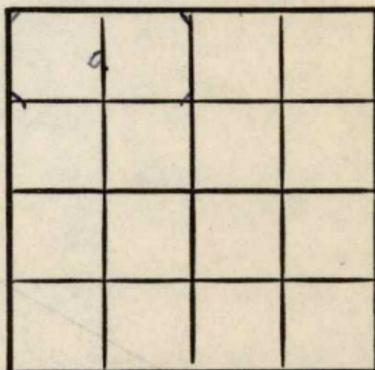

Russell County

Location X

Rig up _____

Drilling and Remarks:

RECORD

Cased _____ in., _____ ft.

Sand _____

Gas _____

Oil _____

Total Depth _____

PRODUCTION

1st 24 hrs. Nat. _____

1st 24 hrs. after shot _____

Gas _____ Cu. Ft.

Dry Hole _____

Abandoned _____

Date

APR 30 1947

19

S. J. LEWIS Scout

Kansas

Map No. 72 Sec. 19 Twp. 13 R. 14W

Well No. 1 Gaynor

B & R etal. Company

COMPLETE

Contractor

C E L NW NW

E.I. 1806
SECTION PLAT

660 Ft. from N. Line

_____ Ft. from S. Line

_____ Ft. from E. Line

990 Ft. from W. Line

0			

Russell County

Location _____

Rig up _____

Drilling and Remarks:

CR 8241
5' @ 8241
1500 ac
Pump 60 88

89 2/4

RECORD

Cased _____ in., _____ ft.

Sand _____

Gas _____

Oil _____

Total Depth 3246

PRODUCTION

1st 24 hrs. Nat. _____

1st 24 hrs. after shot _____

Gas _____ Cu. Ft.

Dry Hole _____

Abandoned _____

Date

JUN 18 1947

19

S. J. LEWIS

Scout