

KANSAS


Russell

Section 19 Township 13 Range 14W

Well No. 3 Gaynor

Company B & R et al Trapp Pool

NORTH

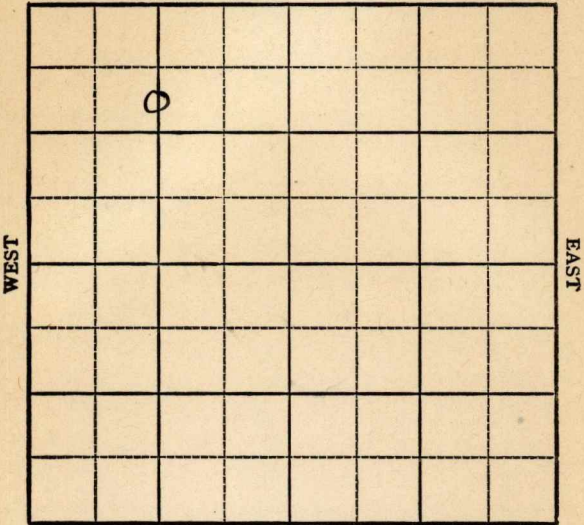

SOUTH

KANSAS

Russell

Sec. 19 Twp. 13 R. 14W ✓

Well No. #3 Gaynor Farm

B & R et al

Company

Trapp Pool


990' Ft. from N. Line

Ft. from S. Line

1320' Ft. from E. Line

Ft. from W. Line

C S L N $\frac{1}{2}$ NW

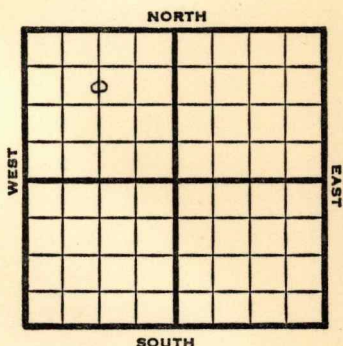

1948

Elev 1813' REPORT

11/10

Location

11/16

8" @ 560'

11/23

Drlg 966'

11/30

Lansing 2978'

TD 2981

5"@ 2979'

12/8

"

12/15

"

12/22

"

12/29

TD 3026'

Swb 20 bbls oil / 1 $\frac{1}{2}$ W PH

1949

1/12

TD 3026'

Lansing 2978'

5"@ 2979'

1000 acid

Pump 20 oil / 15W Pot

38° Gr.

Comp

COMPLETED

Map No. _____ Sec. 19 Twp. 13 R. 14WWell No. 3 Gaynor_____
B & R etal. Company_____
FIRST REPORT ContractorC S L N $\frac{1}{2}$ NW

SECTION PLAT

990 Ft. from N. Line Ft. from S. Line1320 Ft. from E. Line Ft. from W. LineRussell CountyLocation X

Rig up _____

Drilling and Remarks:

RECORD

Cased _____ in., _____ ft.

Sand _____

Gas _____

Oil _____

Total Depth _____

PRODUCTION

1st 24 hrs. Nat. _____

1st 24 hrs. after shot _____

Gas _____ Cu. Ft.

Dry Hole _____

Abandoned _____

Date

NOV 10 1948 19 S. J. LEWIS Scout

Kallias

Map No. 72 Sec. 19 Twp. 13 R. 14WWell No. 3 Gaynor

B & R etal.


Company

COMPLETE

Contractor

C S L N $\frac{1}{2}$ NWE117R3
SECTION PLAT990 Ft. from N. Line Ft. from S. Line1320 Ft. from E. Line Ft. from W. Line

Russell County

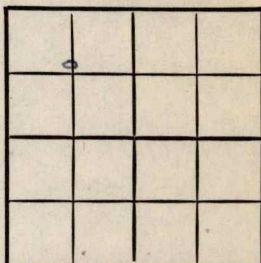

Location

Rig up

Drilling and Remarks:

Lane 2975

5' @ 2979

1000 acid

Pump 20 oil 715 NW

35-6

RECORD

Cased in., ft.Sand Gas Oil Total Depth 3026

PRODUCTION

1st 24 hrs. Nat. 1st 24 hrs. after shot Gas Cu. Ft.Dry Hole Abandoned

Date

JAN 12 1949

19

S. J. LEWIS

Scout