
FORM 51 25M 3-49 PETROL Ness KANSAS

Section 2 Township 17 Range 21 W

Well No. # 1 Elmore

Company Heathman & Co.

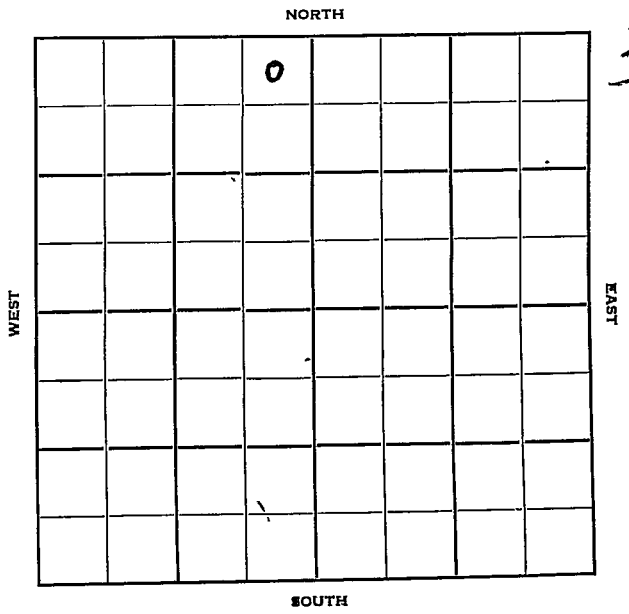

FORM 252-B
10M 8-51 TPCO.

Ness **HOT FILE** KANSAS

Sec. 2 Twp. 17 R. 21W

Well No. #1 Elmore Farm

Heathman & Co. Company

Strain Contractor


Wildcat

330 Ft. from N. Line

Ft. from S. Line

330 Ft. from E. Line

Ft. from W. Line

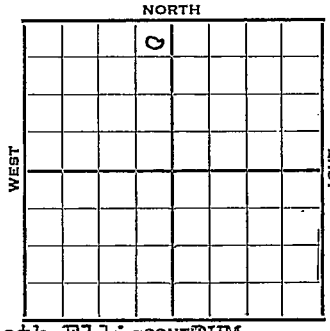

NE NE NW

Vickers FO

Deep Rock-acreage Kenneth Ellis DHM

MAP ACREAGE 1 MI. NE.

1952	Elev. 2201' REPORT
4/30	Location
5/7	8" @ 156 Drlg. 600'
5/14	Anhy 1481 Heeb. 3592 Lans. 3634 Drlg. 3877'
5/21	Spud 5-4-52 D&A TD 4307' 8" @ 156' Anhy 1481 Heeb. 3592 Lans. 3634 B KC 3925 DST 4049-4117' open 3/4 hr. rec. 2600' sw Cong. 4155 Arb. 4190 TD 4307' D&A

ABANDONED

FORM 275 FOR SALE BY KANSAS BLUE PRINT CO.


County Ness State Kansas

Sec. 2 (Blk. Twp.) 17 (Sur. Rge.) 21W Map No.

Operator Heathman & Co.

Well No. 1 Farm Elmore

Elev. Location NE NE NW

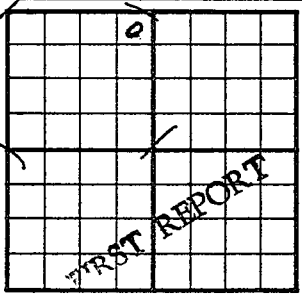

330 Ft. From N Line NW

330 Ft. From E Line Quarter

1st. Report APR 30 1952

Completion

Remarks Vickers-FO Deep Rock-acreage Kenneth Ellison - BHM Strain - Contractor

Spudding Date

Drlg. Data MCPC has NE/4 of 36-16-21W Wildcat Location

J. G. McGEHEE

FORM 275 FOR SALE BY KANSAS BLUE PRINT CO.


County Ness State Kansas

Sec. 2 (Blk. Twp.) 17 (Sur. Rge.) 21W Map No.

Operator Heathman & Co.

Well No. 1 Farm Elmore

Elev. 2201 Location NE NE NW

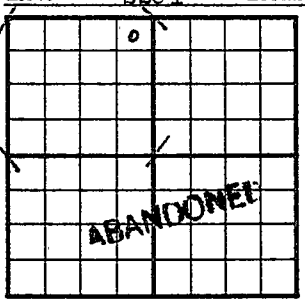

330 Ft. From N Line NW

330 Ft. From E Line Quarter

1st. Report

Completion MAY 21 1952

Remarks Wildcat

Strain Drlg. - Contr.

Spudding Date 5-4-52

Drlg. Data D & A TD 4307

8" @ 156 Anhy 1481 Heeb. 3592

Lans. 3634 B KC 3925 DST 4049-4117

open 3/4 hr. Rec. 2600' sw Cong. 4155

Arb. 4190 Td 4307

D & A

J. G. McGEHEE