


Section 19 Township 13 Range 14 W

Well No. #9 Gaynor

Company Louis Mai

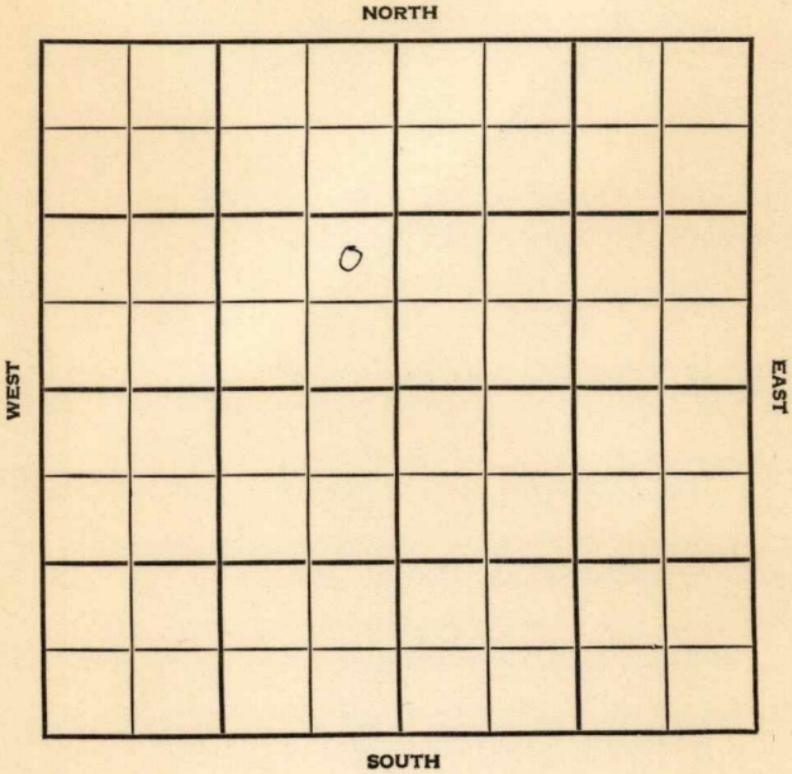

Russell

KANSAS

SEC. 19	TWP. 13	R. 14W
------------	------------	-----------

WELL NO.

#9 Gaynor

FARM

COMPANY

Louis Mai

CONTRACTOR

Mast Drlg.

Russell


_____ Ft. from N. Line

_____ Ft. from S. Line

_____ Ft. from E. Line

_____ Ft. from W. Line

NE SE NW

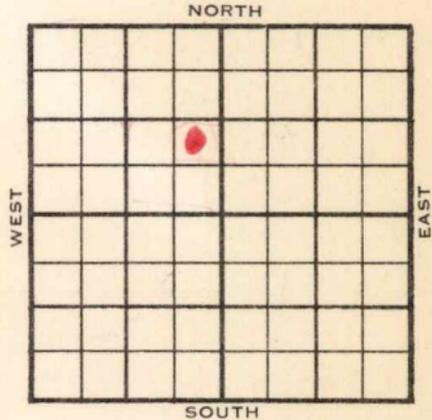

1955	ELEVATION	REPORT
	1754 RB	1751 DF

8/3

Comm 7-21-55
 8" @820 DST 2949-63 open 1 hr. Rec 94'
 msw 295# TD 3190 5" 3187
 Tp. 2638, H. 2864, Tr. 2878, L. 2917,

FIRST REPORT

8/17

500 acid swb 12 to 15 bfph 50% wtr.
 1800' OB POP Pmp 25 bopd plus 50%
 wtr. Tp: 2638, 884, H: 2864, 1110
 Tr: 2878, 1124, L: 2917, 1163, A: 3185
 1431, TD: 3190.

COMPLETED

County Russell Elev. 1754 RB
 Sec. 19 Twp. 13 Rge. 14W
 Company Louis Mai
 Farm Name Gaynor No. 9

TOPS	DEPTH	LOG	DATUM
Anh.			
T.P.	2638		
H.	2864		
Tr.	2878		
Dg.			
B.L.			
L.	2917		
K.C.			
B.K.C.			
Ce.			
C.			
M.			
M.			
K.			
Mz.			
Mq.			
V.			
S.			
S.			
A.			
R.			
PE.			
G.			
T.D.			

Loc. in Sec. NE SE NW

Geol. _____

Contr. Mast Drlg.

Pool Russell

FIRST REPORT
AUG 3 '55

Date Comm. 7-21-55
8" @ 820 DST 2949-63 open 1 hr.
Rec. 94' msw 295# TD 3190 5" @ 3187

12

Co.
Lse.
No.
Sec.
T.
R.

County **Russell** Elev. **1751 DF 1754 RE**
 Sec. **19** Twp. **13S** Rge. **14W**
 Company **Louis Mai**
 Farm Name **Gaynor** No. **9**

TOPS	DEPTH	LOG	DATUM	Loc. in Sec.												
Anh.				NE SE NW												
Tp.	2638		884													
H.	2864		1110													
Tr.	2878		1124													
Dg.																
Bl.																
L.	2917		1163	Geol.												
K.C.				Contr.												
B.K.C.				Mast Drlg.												
Ce.				Pool												
C.				Russell												
M.				<table border="1"> <tr><td></td><td></td><td></td></tr> <tr><td></td><td>0</td><td></td></tr> <tr><td></td><td>AUG 17 1955</td><td></td></tr> <tr><td colspan="3">COMPLETE</td></tr> </table>					0			AUG 17 1955		COMPLETE		
	0															
	AUG 17 1955															
COMPLETE																
M.																
K.																
Mz.																
Mq.																
V.																
S.																
S.																
A	3185		1431													
R.																
Pe.																
G.																
TD	3190															

Date Comm. **7/21/55** 8" 820
 DST 2949-63 open 1 hr rec. 94' msw 295#
 TD 3190 5" 3187 500 Acid Swb 12 To 15bfph
 50% wtr. 1800' OB POP Pmp 25 bopd plus
 50% wtr.

No. Sec. T. R.