

KANSAS


FORM 51 5M BRIX

Ness

Section 26 Township 17 Range 22W

Well No. #1 J R Elmore

Company Sinclair-Prairie

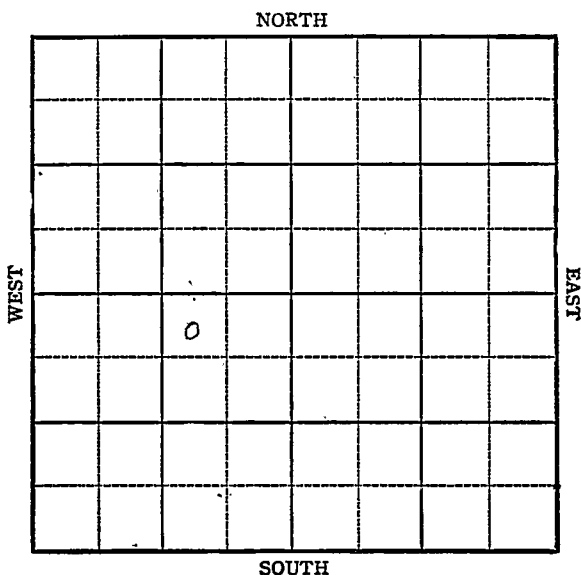

KANSAS

Ness

Sec. 26 17 Twp. 17 R. 22W

Well No. #1, J. R. Elmore Farm

Singlair-Prairie Company

Wildcat

NORTH

330 Ft. from N. Line


 Ft. from S. Line

990 Ft. from E. Line

 Ft. from W. Line

WEST

EAST

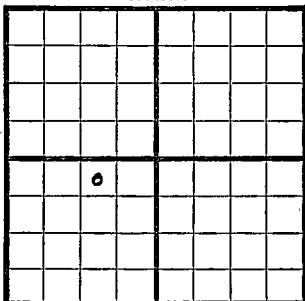

SOUTH

Elev. 2269

1944

REPORT

6/14	Derrick	
6/21	Surface Hole.	
6/28	Drlg 250'	
7/12	10" @ 375	TD
7/19	Drlg 2425	
7/26	Anhy. 1535	
	Ft. Riley 2455	
	Drlg. 3330	
8/2	Drlg. 4006	
8/9	Topeka 3360	
	Eans. 3740	
	Miss 4248	
	Drlg. 4450	
8/16	Viola	4412
	Abb	4582
	TD	4700

ABANDONED

KANSASPool Name WildcatMap No. 76 Sec. 26 Twp. 17 R. 22WWell No. 1 J. R. ElmoreSinclair-Prairie

Company

FIRST REPORT

Contractor


NW NE SW

SECTION PLAT330 Ft. from N. Line

Ft. from S. Line

990 Ft. from E. Line

Ft. from W. Line

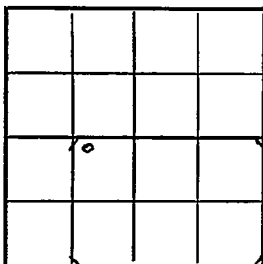Ness County

Location _____

Rig up _____

Drilling and Remarks:

Derrick**RECORD**

Cased _____ in., _____ ft.

Sand _____

Gas _____

Oil _____

Total Depth _____

PRODUCTION

1st 24 hrs. Nat. _____

1st 24 hrs. after shot _____

Gas _____ Cu. Ft.

Dry Hole _____

Abandoned _____

Date

†

JUN 14 1944 19S. J. LEWIS Scout

Pool Name Wildcat

Map No. 76 ^{KANSAS} Sec. 26 Twp. 17 R. 22W

Well No. 1 J. R. Elmore

Sinclair-Prairie Company

ABANDONED Contractor

NW NE SW


SECTION PLAT

330 Ft. from N. Line

 Ft. from S. Line

990 Ft. from E. Line

 Ft. from W. Line

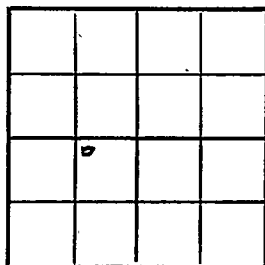

Ness

Location

Rig up

Drilling and Remarks:

Viola 4412

CR 4582

RECORD

Cased in., ft.

Sand

Gas

Oil

Total Depth 4200

PRODUCTION

1st 24 hrs. Nat.

1st 24 hrs. after shot

Gas Cu. Ft.

Dry Hole

Abandoned

Date

AUG 16 1944 19 S. J. LEWIS Scout