Ness

KANSAS


SECTION 24 TOWNSHIP 17 RANGE 23W

WELL NO. #1 Elmore

COMPANY Gulf Oil

NORTH SE SE SW

14

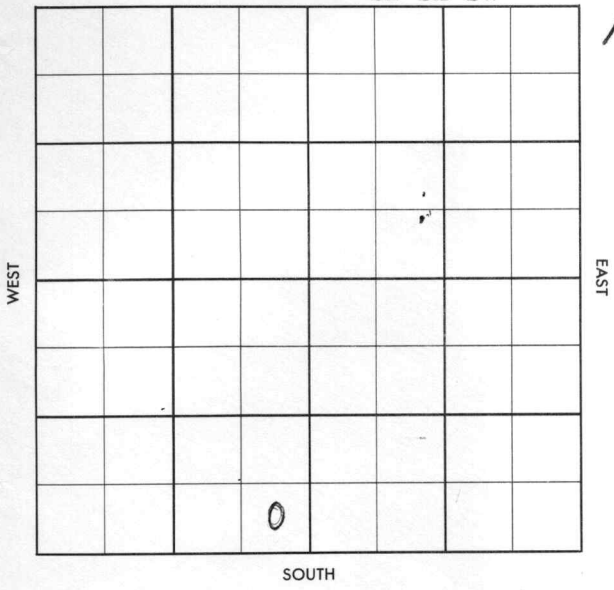

FORM 504-3 SUNRAY

HOT FILE

SEC.	TWP.	R.
24	17 S	23 W


Ness KANSAS

WELL NO. #1 J. R. Elmore FARM

COMPANY Gulf Oil Corp.

CONTRACTOR Lewis Drlg.

Wildcat

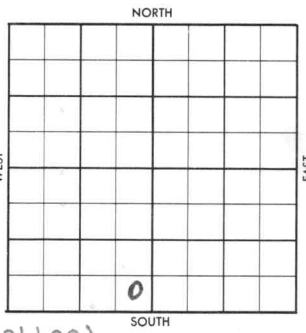

_____ FT. FROM N. LINE

330 FT. FROM S. LINE

2974' FT. FROM E. LINE

_____ FT. FROM W. LINE

of Sec.
SE SE SW

SDX-DHC-$3500.00 (Lse S-34432)

1957	ELEVATION 2390' GL 2397' DF 2400' KB REPORT (WH7-DC12) ✓
	Arbuckle Test appx 4650'
2/21	To be commenced by March 1, 1957 To be completed by April 1, 1957 (See copy DHC Agrt 2-21-57)
2/27	RUR 4650' Arb. (FR Tkt)
2/27	Location staked Spudded 2-26-57 Drlg. 840' (Card-Gulf Oil)
2/28	Top redbeds 905' Ran 8-5/8" @ 915 w/575 sax. Plug to 875'. Drlg. 916' "
3/1	Drlg. 1400' T/Sand 1180' "
3/2	Drlg. 2260' T/Anhy 1685' "
3/3	Trip @ 2665' Lost 300 bbls mud @ 2616' "
3/4	TD 2830'. Working stuck DP Stuck DP 10' off bottom at 6:30 PM after having picked it up to jet pits & mix mud. Spotted 35 BO at 3 AM. Waiting for oil to soak. (Card-Gulf Oil)
3/5	Drlg. ~~XXXX~~ 2995' "
3/7	Drlg. 3585' shale. "
3/8	Drlg. 3820' in shale. "

OVER

1957

~~3/11 TD 4560' Elec. Log.~~
~~P & A 3-9-57~~
~~Sample tops: Miss. 4506',~~
~~Spurgeon 4521'~~
~~Log tops: Heeb 3836', Toronto 3854'~~
~~Lansing 3879' Ft. Scott 4409'~~
~~Cherokee 4432', Cherokee sd 4481'~~
~~Conglomerate 4490', St. Louis 4514'~~
~~Spurgeon 4526'~~

ERROR

1957

3/9 Drlg. 3995' Heebner 3819
L-KC 3868' (Card-Gulf Oil Corp

3/10 Drlg. 4150' in lime. "

3/11 Drlg. 4290' in chalky lime. "

3/12 Top Marmaton 4165', Top Fort Scott 4225', Top Cherokee sd 4362'
Drlg. 4380' "

3/13 TD 4405' in Cherokee Rng. DST #1 Packer at 4357'. Had slight odor in samples. "

3/14 DST#1, in Cherokee, 4357-4405' open 35", w/wk blow for 3" & died. Flushed tool, no improvement. rec 40' drlg. mud, No SO or G. IFP 60# FFP 60# 30"SIP 330#. HP 2380#.
T/Mississippian 4430'
TD 4475'. Prep to take DST #2.
Expect to test interval 4442-4475' "

3/15 DST #2, 4442-4475' in Miss. open 1 hr fair blow, decreasing somewhat at end of test. rec 865' muddy SW. No SO or G. 20"ISIP 1450#. IFP 130# FFP 420#. 30"FSIP 1260#(not static) HP 2380#. BHT 128°.
Drlg. 4582' (Card-Gulf Oil Corp)

3/16 Drlg. 4660' Miss. Lime. "

3/17 Viola 4736' Drlg. 4788' "

3/18 Elec. Log tops: Heeb 3820', LKC 3868', Cherokee 4363', Miss. 4434', Viola 4738 Simpson 4854', Arb. 4871'
Microlog tool hung at 4463'. Were unable to work free after 1½ hrs. Did not run back w/ML to log from 4463-Heebner.
TD 4895' Standing for interpretation of logs. (Card-Gulf Oil Corp.)

3/19 Received copy Radiation Guard Log.- Given to SA Shannon, Div. Geol. Wichita District.

#1 J. R. Elmore

1957

3/19 TD 4895'. P & A 3-19-57(Card-Gulf Oil

3/21 (Received copy of Halliburton Guard Log and Contact Log. - Given To S.A. Shannon, Div. Geolog. Wichita District)

3/22 (Advised Contract Section- P & A) ✓

WILDCAT

FORM 513 SUNRAY

County Ness Elev. 2380

Sec. 24 Twp. 17 Rge. 23W

Company Gulf Oil

Farm Name Elmore No. 1

TOPS	DEPTH	LOG	DATUM
Anh.			
Tp.			
H.			
Tr.			
Dg.			
Bl.			
L.			
K.C.			
B.K.C.			
Ce.			
C.			
M.			
M.			
K.			
Mz.			
Mo.			
V.			
S.			
S.			
A			
R.			
P€.			
G.			
T.D.			

Loc. in Sec.
SE SE SW
4650' Arb.

Geol.

Contr.
Lewis Drlg.

Pool
Wildcat

FIRST REPORT

FEB 27 '57

D

Date Comm.

SDX - DHM

R U R

Co. Lse. No. Sec. T. R.

FORM 513 SUNRAY

County Ness Elev. ~~2380~~ 2397 DF

Sec. 24 Twp. 17 Rge. 23W

Company Gulf Oil

Farm Name Elmore No. 1

	DEPTH	LOG	DATUM
Anh.	1685		
Tp.			
H.	3819	3820	
Tr.			
Dg.			
Bl.			
L.	3868	3868	
K.C.			
B.K.C.			
Ce. sd	4362	4363	
C. Miss	4465		
M. Miss		4434	
M. Ft Sct Lm	4225		
K. Cesd	4362		
Mz.			
Mo. Miss	4430		
V.	4736	4738	
S.	4853	4854	
S.			
A	4870	4871	
R.			
Pe.			
G.			
T.D.	4895		

Loc. in Sec. SE SE SW

4650' Arb.

Geol.

Contr. Lewis Drlg.

Pool Wildcat

ABANDONED

MAR 20 '57

0

Date Comm. SDX - DHM

R U R MAR 6 '57 spd 2-26-57

12¼ @ 26' 8⅝ 915/575

@ 2995 MAR 13 '57 ~~3380~~ MAR 20 '57 X Tops

DST 4357-4405 op 35" rec 20' Md

FP 60-60 BHP 330 DST 4442-75 op

thin rec 865' MSW N.S. FP 130-420

BHP 1260

D & A