


Section 2 Township 17 Range 24 W

Well No. #1 Bertha Harchen

Company Welch & Olsson

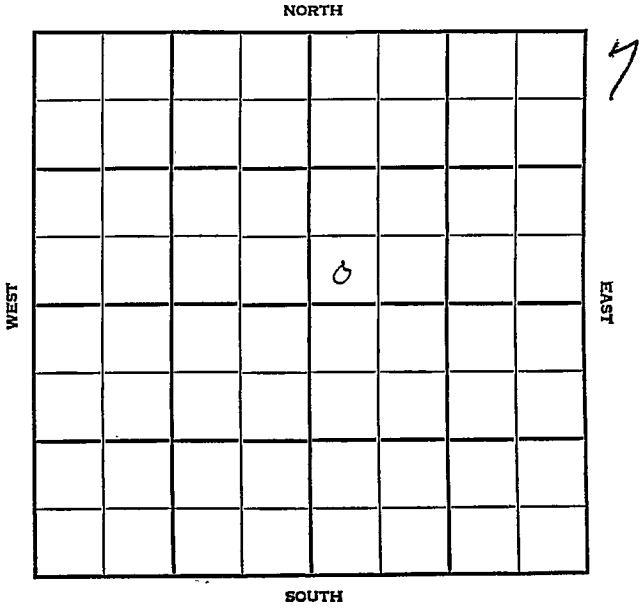

Noss

KANSAS

SEC. 2 -	TWP. - 17	R. 24W
-------------	--------------	-----------

WELL NO.

#1 Bertha Harchen

FARM

COMPANY

Welch & Olsson

CONTRACTOR

Co. tools

WILDCAT


_____ Ft. from N. Line

_____ Ft. from S. Line

_____ Ft. from E. Line

_____ Ft. from W. Line

SW SW NE

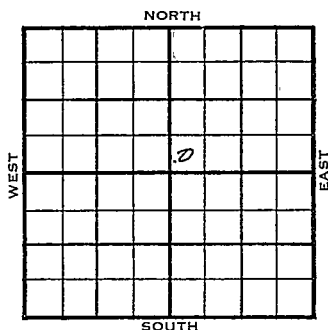

1955

ELEVATION

2514'

REPORT

9-14

Cellar & pits

11-16

Comm. 10-31-55

8 5/8" @ 135/125

DST 4396-4425 op 1/2 hr. rec. 10' mud
0/20"DST 4494-4500 op 3/4 hr. rec. 10' mud
790/20"DST 4500-05 op 1 hr. rec 15' wm
1040/20"

D & A - TD 4595'

TopsDepthLog

H.

3851-

3850

Tr.

3870

L.

3892

3894

B.K.C.

4190

4187

Ft. Scbtt

4394

4390

Ce

4463

4463

ABANDONED

County Nesse Elev. _____
 Sec. 2 Twp. 17 Rge. 2NW
 Company Welch & Olsson
 FarmName Bertha Harchen No. 1

TOPS	DEPTH	LOG	DATUM
Anh.			
TP.			
H.			
Tr.			
Dg.			
Bl.			
L.			
K.C.			
B.K.C.			
Ce.			
C.			
M.			
M.			
K.			
Mz.			
Me.			
V.			
S.			
S.			
A.			
R.			
Pe.			
G.			
T.D.			

Loc. in Sec. _____
SW SW NE
 Geol. _____
 Contr. _____
Co. tools
 Pool _____
Wildcat

14	55
	0

FIRST REPORT

Date Comm. _____
Gellar & pits

[Handwritten signature]

Co.
Lse.
No.
Sec.
T.
R.

County	Ness	Elev.	2514
Sec.	2	Twp.	17
Company	Welch & Olsson & Aurora		
Farm Name	Bertha Horchem	No.	1

TOPS	DEPTH	LOG	DATE	Loc. in Sec.
Anh.				SW SW NE
Tr.				
H.	3851	3850	1336	
Dg.		3870	1356	
Bl.				
L.	3892	3894	1380	
K.C.				Geol.
B.K.C.	4190	4187	1673	Contr.
Ce. Ft Scott	4374	4396	1876	Co. tools
Ce.	4465	4463	1949	
M.	4493	4489	1975	Pool
M.				Wildcat
K.				
Mz.				
Me.				
V.				
S.				
S.				
A.				
R.				
Pe.				
G.				
T.D.	4595			

Date Comm.	10-31-55	NOV 16 1955
8 5/8" @ 137/125	DST 4396-4425	
open 1/2 hr.	rec. 10' mud	0/20"
DST 4494-4500	open 1/2 hr.	rec. 10' mud
790/20"	DST 4500-05	open 1 hr.
rec. 15' wm	1040/20"	

D & A