


Ness

KANSAS

SECTION 7 TOWNSHIP 17S RANGE 24W

WELL NO. #1 Tillitson

COMPANY E.K. Carey

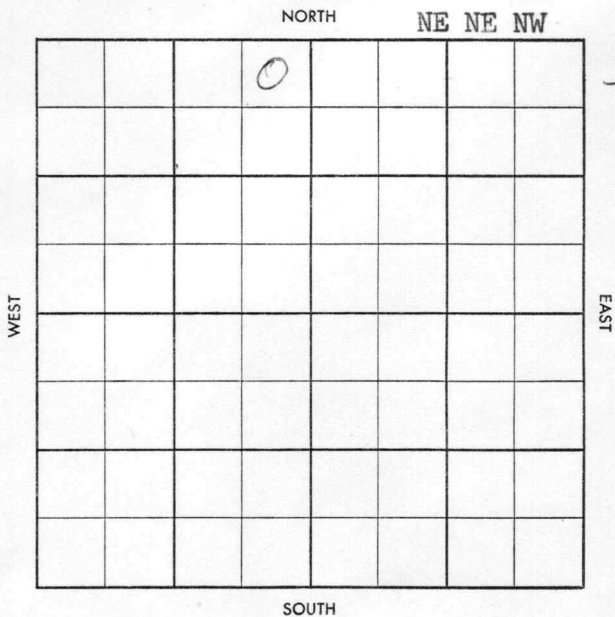

Twp. ~~_____~~ Pool ~~_____~~

Co. ~~_____~~ Facet ~~_____~~

WILDCAT

18B

S-513-B

County Ness Elev. _____

Sec. 7 Twp. 17 Rge. 24W

Company E. K. Carey

Farm Name Tillitson No. 1

TOPS	DEPTH	LOG	DATUM
Anh.			
Tp.			
H.			
Tr.			
Dg.			
B.L.			
L.			
K.C.			
B.K.C.			
Ce.			
C.			
M.			
M.			
K.			
Mz.			
Mq.			
V.			
S.			
S.			
A.			
R.			
Pf.			
G.			
T.D.			

Loc. in Sec. _____

NE NE NW

Geol. _____

Contr. _____

Cappitt Drlg

Pool _____

Wildcat



Date Comm. _____ (Ohio - FO)

MIRT

Co.

Loc.

No.

Sec.

T.

R.

Twp. Pool

Co. Facet

S-513-B

County Ness Elev. 2454 DF
 Sec. 7 Twp. 17 Rge. 375700 2W
 Company E. K. Carey
 Farm Name Tillitson No. 1

TOPS	DEPTH	LOG	DATUM
Anh.			
Tp.			
H.	3911	3911	
Tr.	3832	3933	
Dg.			
B.L.			
L.	3852	3852	
K.C.			
B.K.C.	4148	4145	
Ce.	<u>MDVM</u>	4222	
C.	<u>F1 SCOT</u>	4353	
<u>C</u>	4350	4423	
M.		4458	
K.			
Mz.			
Mq.			
V.			
S.			
S.			
A.			
R.			
Pf.			
G.			
T.D.	4505	4505	

Loc. in Sec. NE NE NW
 Geol. _____
 Contr. Cappitt Drlg
 Pool Wildcat

D
APR 23 '58
ABANDONED

Date Comm. 3-26-58 (Ohio - FO)
 MIPT 8" 316 3257
APR 9 '58 DST 4331 - 75 OP 30" 10' SOCM
BHP 385 4375 APR 18 '58 APR 23 '58

DOA