


Ness

KANSAS

SECTION 18 TOWNSHIP 17 RANGE 24W

WELL NO. #1 Miek "A"

COMPANY Barnett Oil

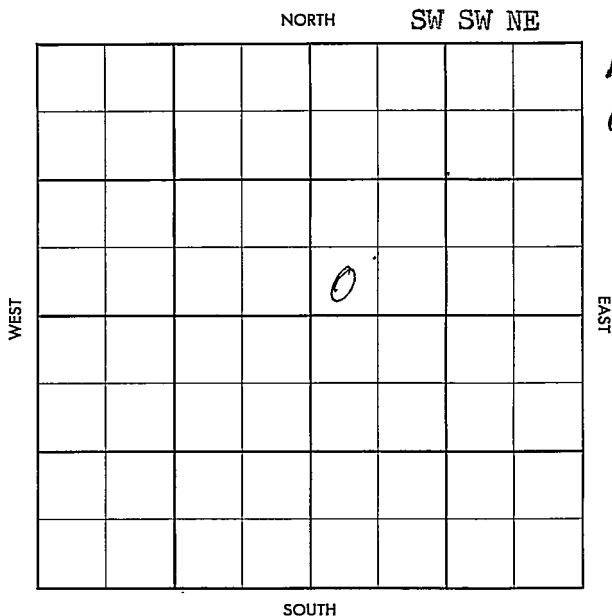

WILDCAT

FORM 513 SUNRAY

County Ness Elev. _____
 Sec. 18 Twp. 17 Rge. 24W
 Company Barnett Oil
 Farm Name Miek "A" No. 1

TOPS	DEPTH	LOG	DATUM	Loc. in Sec.
Anh.				SW SW NE
Tp.				
H.				
Tr.				
Dg.				
Bl.				
L.				Geol. _____
K.C.				Contr. _____
B.K.C.				Co. tools _____
Ce.				Pool _____
C.				
M.				
M.				
K.				
Mz.				Wildcat
Me.				
V.				
S.				
S.				FIRST REPORT
A.				
R.				
PE.				
G.				
T.D.				

Date Comm. Thamlin - DHM
M I R

Co.

Lse.

No.

Sec.

T.

R.

County Ness Elev. 2447
 Sec. 18 Twp. 17 Rge. 24W
 Company Barnett Oil
 Farm Name Miek "A" No. 1

Co.

TOPS	DEPTH	LOG	DATUM
Anh.	1725		
Tp.			
H.		3759	
Tr.		3778	
Dg.			
Bl.			
L.	3805	3801	
K.C.			
B.K.C.	4098	4094	
Ce.	FTSCT 4314		
C.	ce 4360	4357	
M.	chert 4426	4420	
M.	Dolo	4428	
K.			
Mz.			
Me.			
V.			
S.			
S.			
A.			
R.			
PE.			
G.			
T.D.	4527		

Loc. in Sec. SW SW NE

Geol.

Contr.

Co. tools

Pool

Wildcat

ABANDONED

0

MAY 22 57

Loc.

No.

Sec.

T.

R.

Date Comm. Champlin - DHM

M I R MAY 15 57 5-7-57 85.7

212/175 M 3775 MAY 22 57

DST 4400-10 1hr 6' Md 80/30

DST 4411-30 1hr 7' Md BHP

105/36"

D & A