

**GEOLOGICAL DEPARTMENT
UNION GAS CORPORATION
INDEPENDENCE, KANSAS**

PL.

Company **Fred Alexander**

S. T. R. 19-28-17
County Wilson
State Kansas
Lease and Well No. Don Van Vickle #1
Elev. 991

Contractor

Drilling Commenced


Drilling Completed **1926**

Initial Production

Initial Rock Pressure

Location **440' from the W. line and 570' from the N. line of the NW $\frac{1}{4}$ of the NW $\frac{1}{4}$.**

Casing **6 $\frac{1}{2}$ " 430'**

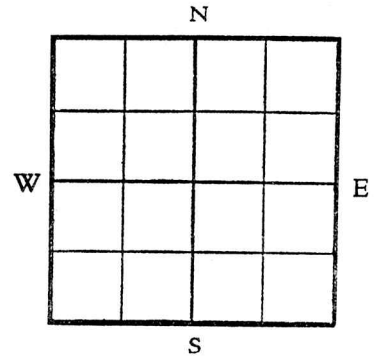

Driller's Record of Formations

soil	3
shale and rock	5
shale	100
lime	102
sand light	205 3 blrs. water
lime	215
shale	235
lime	310
shale	350
lime	372
shale	381 water and gas
lime	426
shale	478
lime	483
shale	493
lime	501
shale	506
lime	530
shale	547
gas sand dry	559
shale	630
lime	665
shale	699
lime	718
shale black	725 water and gas
lime	732
shale black	758 gas and water
lime	740 T.D.