

Well No. #2 Hasket

Company McNish & Grallop

A 10x10 grid map. The top edge is labeled 'NORTH', the bottom edge is labeled 'SOUTH', the left edge is labeled 'WEST', and the right edge is labeled 'EAST'. A small black circle with the number '0' inside is located in the third column from the left and the fifth row from the bottom.

Cowley

KANSAS


 Sec. 19 Twp. 33 R. 3 E

 Well No. # 3 Heskett Farm

McNish & Grallop Company

Contractor


_____ Ft. from N. Line

330 Ft. from S. Line

990 Ft. from E. Line

_____ Ft. from W. Line

SW SE NW

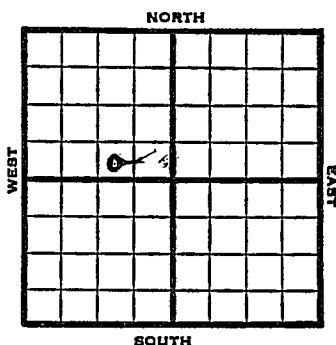

1953

Elev. 1108' REPORT

2/11

Spud 2-7-53

10" @ 96

Drlg. 200'

3/18

Spud 2-7-53 Oil well TD 3208

10" @ 96 Bart. 3191 Miss 3208

TD 3208 7" @ 3192 CO to 3208

Sand-frac.

Comp. 25 BOPD

COMPLETED

County **Cowley** State **Kansas**

Sec. 19 (Blk. Twp.) 33 (Sur. Rge.) 3E Map No.

Operator **McNish & Grallop**

Well No. **3** Farm **Heskett**

Elev.	Location	SW	SE	NW
-------	----------	----	----	----

b

FIRST REPORT

330 Ft. From S Line NW

990 Ft. From E Line Quarter

1st. Report FEB 11 1953

Completion

Remarks

Spudding Date **2-7-53**

Drig. Data

10" @ 96 drlg. 200

J. G. McCEHEE

County Cowley State Kansas
 Sec. 19 (Blk. Twp.) 33 (Sur. Rge.) 3E Map No. _____
 Operator McNish & Grallop
 Well No. 3 Farm Heskett
 Elev. 1108 Location SW SE NW

330 Ft. From S Line NW
 990 Ft. From E Line Quarter

1st. Report _____

Completion MAR 18 1953

Remarks _____

Spudding Date 2-7-53

Drilg. Data Oil well TD 3208

10" @ 96 Bart. 3191 Miss. 3208

TD 3208 7" @ 3192 CO to 3208

wd-frac Comp. 25 bopd

J. G. McGEHEE