

Cowley

KANSAS

Section 19 Township 33 Range 3 E

Well No. # 3 Holman

Company McNeish & Grallop

NORTH

		0					

WEST

EAST

SOUTH

Cowley

KANSAS ✓

Sec. 19 Twp. 33 R. 3 E

Well No. # 3 Holman Farm

McNeish & Grallop Company

Watson Contractor

Rainbow Bend Pool


330 Ft. from N. Line

Ft. from S. Line

990 Ft. from E. Line

Ft. from W. Line

NW NE SW

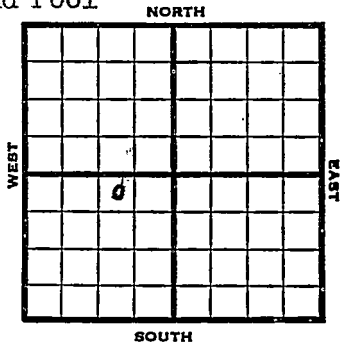

1953 Elev. 1109' REPORT

6/24 Spud 6-18-53
8" @ 95
Drlg. 2395'

8/12 Spud 6-18-53
Oil Well
TD 3212
8" @ 95
Bart 3192
TD 3212
5" @ 3192
CO to 3212
~~PB 3202~~
PB 3202 frac
Comp. 50 bopd

COMPLETED

