


DX 78-1 Cowley

KANSAS

Section 19 Township 33 Range 3E

Well No. #4 Holman

Company McNeish & Gralapp

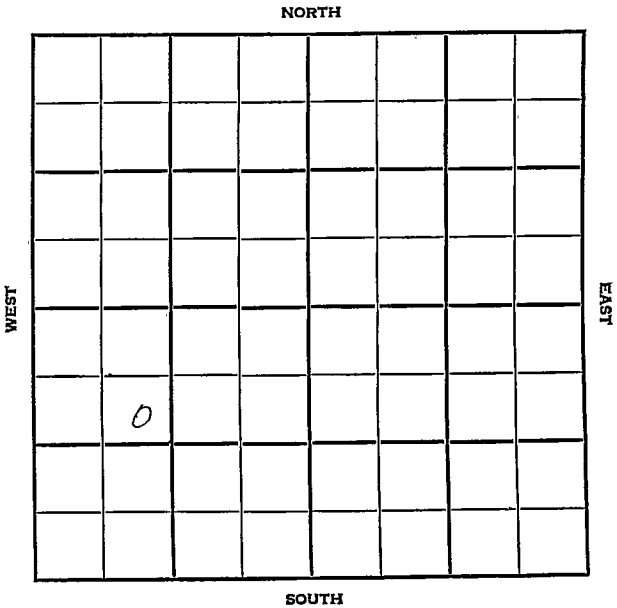

SEC. 19	TWP. 33	R. 3E
------------	------------	----------

WELL NO. #4 Holman FARM

COMPANY McNeish & Gralapp

CONTRACTOR

Rainbow Bend


_____ Ft. from N. Line

_____ Ft. from S. Line

_____ Ft. from E. Line

_____ Ft. from W. Line

SE NW SW

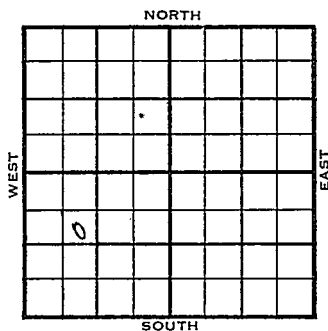

1956	ELEVATION 1109'	REPORT
------	--------------------	--------

3-21 Location

4-11 Comm. 3-19-56
 8 5/8" @ 120 w/100
 5 1/2" @ 3185
 PB 3202
 # CO to 3202, frac
 Comp. 100 bopd
 Log tops:
 Layton 2574
 KC 2752
 Oswego 2991
 Bart 3124
 Chert 3202
 TD 3205

COMPLETED

County Cowley Elev. 1109
 Sec. 19 Twp. 33 Rge. 3E
 Company McNairsh & Gralapp
 FarmName Holman No. 4

TOPS	DEPTH	LOG	DATUM
Anh.			
Tr.			
H. <u>Linton</u>		<u>2574</u>	<u>1465</u>
Dg.			
Bl.			
L.			
K.C.		<u>2752</u>	<u>1643</u>
B.K.C. <u>Chambers</u>		<u>2991</u>	<u>1882</u>
Ce. <u>Bart</u>		<u>3134</u>	<u>2025</u>
C.			
M.			
M. <u>West</u>		<u>3203</u>	<u>2094</u>
K.			
Mz.			
Mo.			
V.			
S.			
S.			
A.			
R.			
PE.			
G.			
T.B.	<u>3205</u>		

Loc. in Sec. SE NW SW

Geol. _____
 Contr. _____

Pool Rainbow Bend

COMPLETE		
e		

Date Comm. 3-19-56 APR 1 1 1956
8 5/8" @ 120/100 5 1/2" @ 3185 PB 3202
CO to 3202 frac Comp. 100 bopd

Co. No. Sec. T. R.