


DX 78-1

Ness KANSAS

Section 23 Township 17 Range 25W

Well No. 2 John C. Shearer

Company Magnolia Petr.

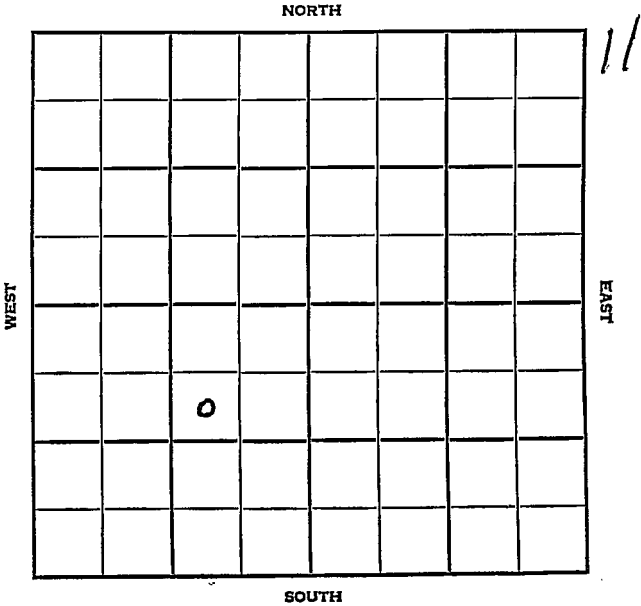

Ness KANSAS

SEC.	TWP.	R.
23	17	25W

WELL NO. 2 John C. Shearer FARM

COMPANY Magnolia Petr.

CONTRACTOR Barnett


NE Aldrich Pool

990 Ft. from N. Line

Ft. from S. Line

990 Ft. from E. Line

Ft. from W. Line

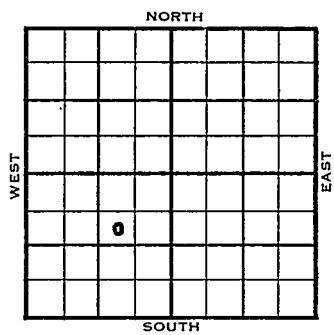

SW NE SW

1955	ELEVATION	REPORT
	2470'	

1/26 Location  
 3/16 Spud 1-26-55 Oil Well TD 4810  
 9 5/8" @ 234 Ft. Scott 4281  
 DST 4274-4306 open 1 hr gas in  
 1 hr, Rec 120' G&OCM 600' gassy  
 muddy oil, 1040# Miss 4379,  
 Warsaw 4449; Osage 4509, Viola  
 4660, Arb 4726,  
 TD 4810 7" @ 4807, PB 4777  
 56/4758-72 2000A 135 BSPH  
 SP 4460 16/4422-26 S/10 GO  
 20 GWPH 6 hr SP 4437 32/4410-  
 18 SP 4419 S/25 BOPH 2 hr  
 SP 4406, 104/4378-4404  
 S/83 BO 4 hr  
 Comp. 1320 BOPD 6% wtr.

**COMPLETED**



County Ness State Kansas  
 Sec. 23 (Blk. 17 (Sur. 25W Map No.  
 (Twp. (Rge.)  
 Operator Magnolia Pet.  
 Well No. 2 Farm John C. Shearer  
 Elev. 2470 Location SW NE SW


990 Ft. From N Line SW

990 Ft. From E Line Quarter

1st. Report

Completion MAR 16 1955

Remarks NE Aldrich Pool

Barnett - Contr.

Spudding Date 1-26-55

Drlg. Data Oil well TD 4810

9 5/8" @ 234 Ft. Scott 4281 DST 4274-

4306 open 1 hr. gas in 1 hr. Rec.

120' g &amp; ocm 600' gassy muddy oil 1040#

Miss. 4379 Warsaw 4449 Osage 4509

Viola 4660 Arb. 4726 TD 4810 7" @

4807 PB 4777 56/ 4758-72 2000 A

135 bwph SP 4460 16/ 4422-26

S/ 10 go 20 gwph 6 hr. SP 4437

32/ 4410-18 SP 4419 S/ 25 boph 2 hr.

SP 4406 104/ 4378-4404 S/ 83 bo 4 hr.

Comp. 1320 bopd 6% wtr.

FABEN GILSTRAP