


Section 24 Township 17 Range 25 W

Well No. #1 Phyliss Potter

Company Magnolia Pet.

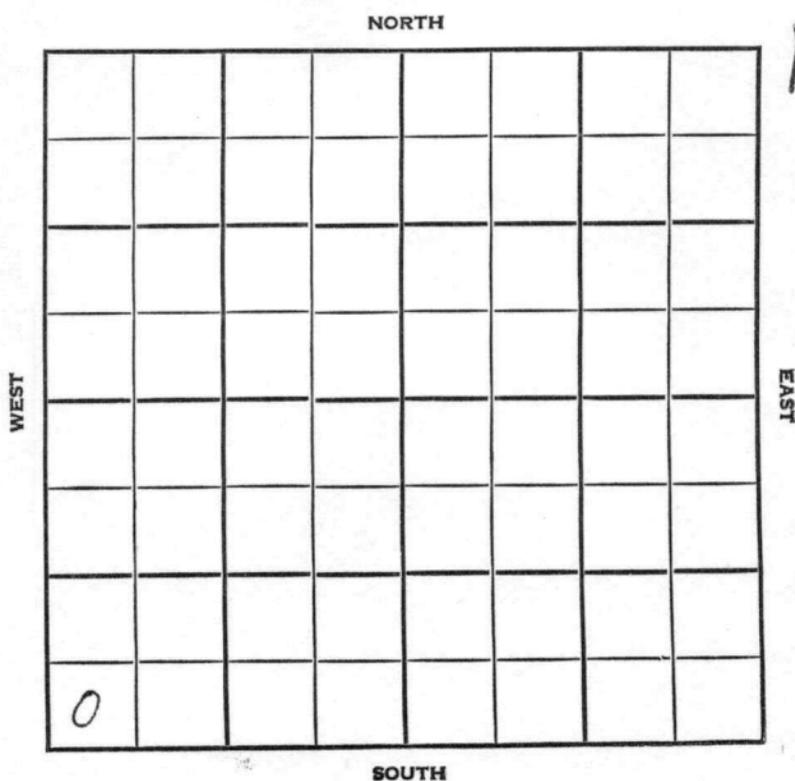

Ness

KANSAS

SEC.	24	TWP.	17	R.	25W
------	----	------	----	----	-----

WELL NO. #1 Phyllis Potter FARM

COMPANY Magnolia Pet.

CONTRACTOR


NE Aldrich

_____ Ft. from N. Line

_____ Ft. from S. Line

_____ Ft. from E. Line

_____ Ft. from W. Line

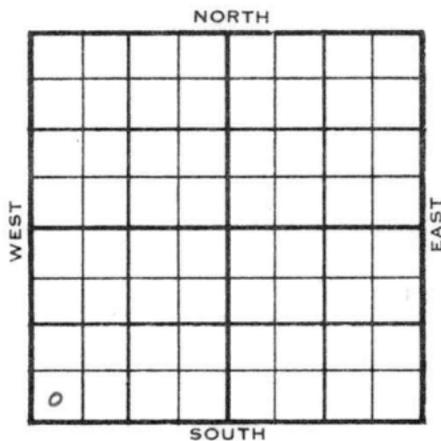

SW SW SW

1955

ELEVATION

2487'

REPORT

8/24

Location

10/12

Comm 9-10-55

8 5/8" @ 237/150

Anh 1730

H 3777

L 3818

Ft. Scott 24320

M 4421

TD 4490

DST 3933-48 open 1 hr Rec 125' mw

1230/20" DST 4035-50 open 1 hr

rec 95' mw 1290/20" DST 4321-43

open 1 hr rec 20' o & gcm 545/20"

BST 4417-35 open 1 hr Rec 117' oily

mud 180' mo 120' ~~EE~~ clean oil

930/20" 5 1/2" @ 4489/200 CO to

4455 20/4419-24 24/4429-35

S/33 bo 10 hr 250 A S/32 bo 215 bw

10 hr. PB 4433 S/20 bwph S/5 bo

13 bwph 6 hr CO to 4455 re perf

16/4429-32 20/4419-29 B/7 bo 12 hr

110 A S/19 bo 5 hr

Comp 72 bopd

COMPLETED

County Ness Elev. _____
 Sec. 24 Twp. 17 Rge. 25W
 Company Magnolia Pet.
 Farm Name Phyllis Potter No. 1

TOPS	DEPTH	LOG	DATUM
Anh.			
Tr.			
H.			
Tr.			
Dg.			
B.L.			
L.			
K.C.			
B.K.C.			
Ce.			
C.			
M.			
M.			
K.			
Mz.			
Me.			
V.			
S.			
S.			
A.			
R.			
PE.			
G.			
T.D.			

Loc. in Sec. SW SW SW

Geol. _____
 Contr. _____

Pool NE Aldrich

FIRST REPORT
 AUG 24 1951

Date Comm. _____
 Location _____

Co.
 Lse.
 No.
 Sec.
 T.
 R.

County Ness Elev. 2487
 Sec. 24 Twp. 17 Rge. 25W
 Company Magnolia Pet.
 Farm Name Phyllis Potter No. 1

TOPS	DEPTH	LOG	DATUM	Loc. in Sec.
Anh.	1730			SW SWSW
Tp.				
H.	3777		1290	
Tr.				
Dg.				
B.L.				
L.	3818		1331	
K.C. #5 Scott	4320		1833	Geol.
B.K.C.				Contr.
Ce.				
C.				
M.	4421		1934	Pool
M.				NE Aldrich
K.				
Mz.				
Me.				
V.				
S.				
S.				
A				
R.				
Pe.				
G.				
T.D.	4490			0

COMPLETE

Date Comm. 9-10-55 OCT 12 1955
8 5/8" @ 237/150 DST 3933-48 open 1 hr.
Rec. 125' mw 1230/20" DST 4035-50
open 1 hr. rec. 95' mw 1290/20"
DST 4321-43 open 1 hr. rec. 20' o & gcm
515/20" DST 4417-35 open 1 hr. Rec.
117' oily mud 180' mo 120' clean oil
930/20" 5 1/2" @ 4489/200 CO to 4455
20/ 4419-24 24/ 4429-35 S./33 bo 10 hr.

OVER

250 A S/ 32 bo 215 bw 10 hr. PB 4433
S/ 20 bwph S/ 5 bo 13 bwph 6 hr.
CO to 4455 reperf. 16/ 4429-32
20/ 4419-29 B/ 7 bo 12 hr. 110 A
S/ 19 bo 5 hr. Comp. 72 bopd

Scout Cards
Land Small Map
Land Wall Map
Tracings
France Map
Pierce Map
Misc.

OCT 24 1955