


Ness KANSAS

DX 78-1

Section 23 Township 17 Range 25W

Well No. 1 Shearer

Company Barnett Oil

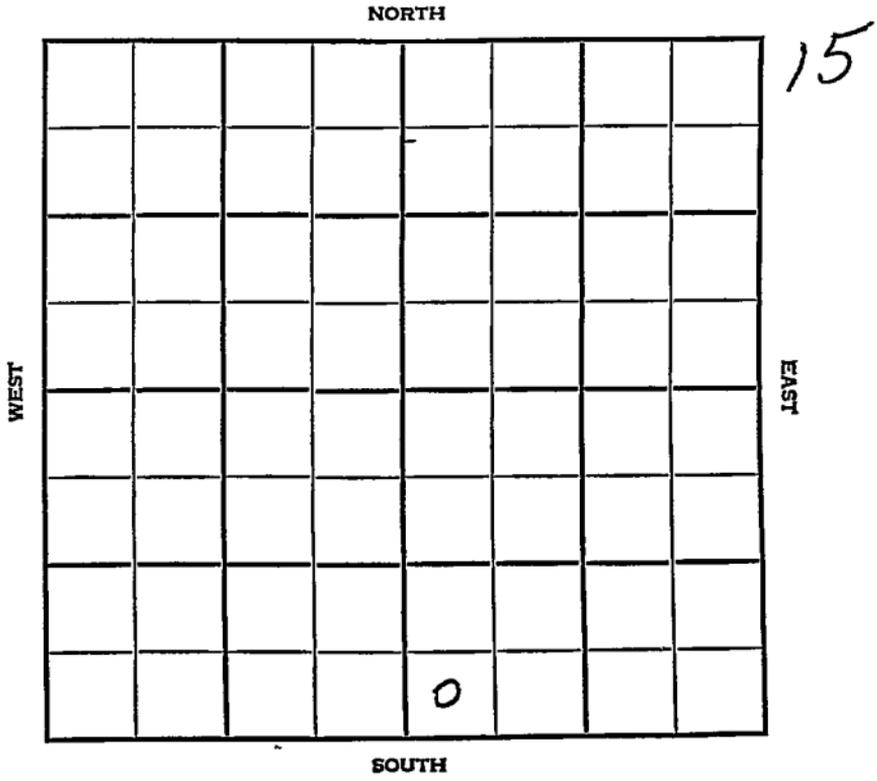

SEC. 23 TWP. Ness KANSAS R. 25W ✓

WELL NO. 1 Shearer FARM

COMPANY Barnett Oil


CONTRACTOR Barnett Wildcat

\_\_\_\_\_ Ft. from N. Line

330 \_\_\_\_\_ Ft. from S. Line

\_\_\_\_\_ Ft. from E. Line

330 \_\_\_\_\_ Ft. from W. Line

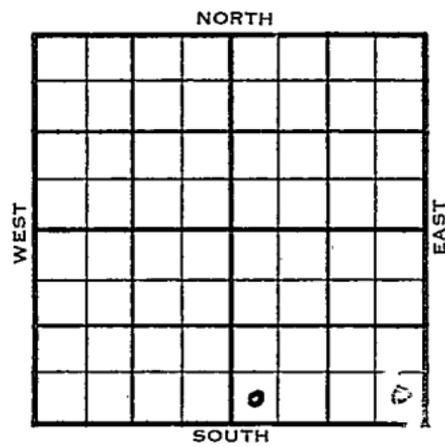

SE SE SE  
Magnolia FO & DHM

	ELEVATION	REPORT
1954	2488'	

7/7 Spudding 6-29-54  
8" @ 206  
Anhy 1727  
Drlg. 3180

7/21 Heeb 3759', Lans 3810', Cong 4385'  
DST 4381-4405', 1½ hrs., 65' OCM,  
900#  
RTD 4405'  
5" @ 4399'

8/18 Spud 6-29-54 Oil well TD 4405'  
8" @ 206 Anhy 1727 Heeb 3759  
Lans. 3810 Cong. 4385'  
DST 4381-4405 open 1½ hr rec 65' OCM  
900# TD 4405 5" @ 4399  
CO to 4405 S/18 GOPH 500 A  
S/2½ BOPH Comp. 66 BOPD

**COMPLETED**



