


Section 24 Township 17 Range 25W

Well No. #1 Potter

Company Francis Oil & Gas

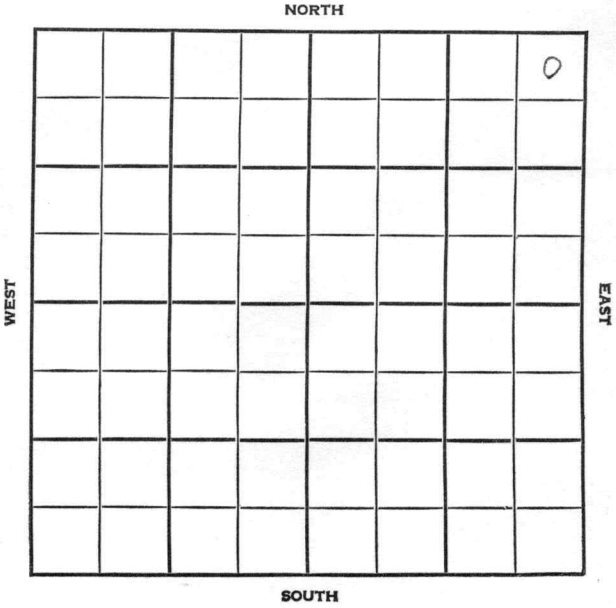

County Ness Elev. _____
 Sec. 24 Twp. 17 Rge. 25W
 Company Francis Oil & Gas
 Farm Name Potter No. 1

TOPS	DEPTH	LOG	DATUM
Anh.	<u>1660</u>		
Tp.			
H.			
Tr.			
Dg.			
Bl.			
L.			
K.C.			
B.K.C.			
Ce.			
C.			
M.			
M.			
K.			
Mz.			
Mq.			
V.			
S.			
S.			
A.			
R.			
PE.			
G.			
T.D.			

Loc. in Sec. _____
NE NE NE
 Geol. _____
 Contr. _____
Barnett
 Pool _____
NE Aldrich

FIRST REPORT
 JUN 27 '56

Date Comm. 6-21-56 Magnolia - FO
8" @ 162/150 drlg. 2600

(Faint mirrored text: JUN 5 9 1956)

(Large handwritten mark: 15)

(Faint mirrored text: JUN 5 9 1956)

(Handwritten mark: 212)

Co.

Lse.

No.

Sec.

T.


R.

4713
2382
-1955

County Ness Elev. 2388
 Sec. 21 Twp. 17 Rge. 25W
 Company Francis Oil & Gas
 Farm Name Potter No. 1

TOPS	DEPTH	LOG	DATUM
Anh.	1660		
TP.			
H.	3702		
Tr.	3725		
Dg.			
BL.			
L.	3744		
K.C.			
B.K.C.	40.35		
Ge. FT SCT	4246		
C.	4317		
M. <u>TC-work</u>	4331		
M. <u>Dolo</u>	4343		
K.			
Mz.			
Me.			
V.			
S.			
S.			
A.			
R.			
PE.			
G.			
TD.	4399		

Loc. in Sec. NE NE NE
 Geol. _____
 Contr. Barnett
 Pool NE Aldrich

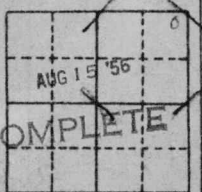

Date Comm. 6-21-56 Magnolia - FO
8" @ 162/150 drl. 2600 JUL 3 '56

3882 JUL 11 '56 DST 4247-75 dr
1 hr rec 20' Md BHP 0/20"
 DST 4345-51 1 hr rec 370' oil +
90' Md y oil + 30' ocm + 10' wtr
BHP 1150/15" 5 1/2 @ 4399/200
 JUL 18 '56 ^{4352 56} 20/4343-48 & 3730 +
12 BW in 12 hrs JUL 25 '56 AUG 1 '56
P. 53 30 + 6 1/2 BW 24 hrs
 AUG 8 '56 AUG 15 '56 PHP 89 BOPD 40% wtr 39

Co.
 Lsc.
 No.
 Sec.
 T.
 R.