


DX 78-1

Ness KANSAS

Section 26 Township 17 Range 25W

Well No. 2 Shearer "B"

Company Barnett Oil

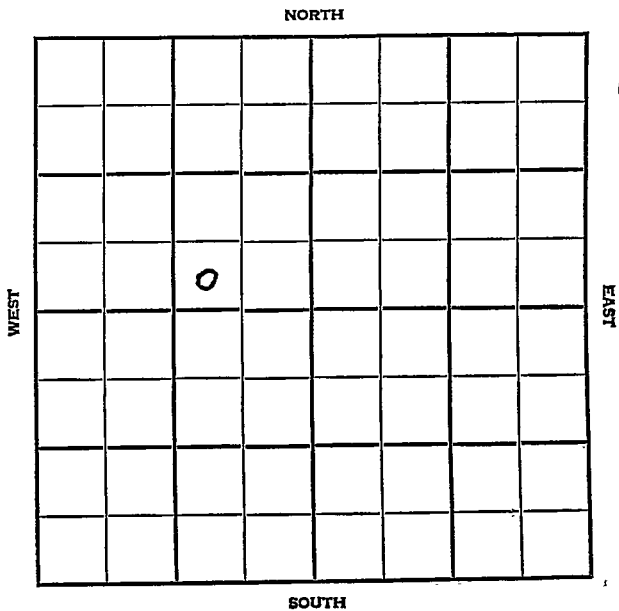

Ness

KANSAS

SEC.	TWP.	R.
26	17	25 W

WELL NO.

# 2 Shearer "B"

FARM

COMPANY

Barnett Oil

CONTRACTOR

Barnett

NE Aldrich Pool


\_\_\_\_\_ Ft. from N. Line

330 \_\_\_\_\_ Ft. from S. Line

990 \_\_\_\_\_ Ft. from E. Line

\_\_\_\_\_ Ft. from W. Line

SW SE NW

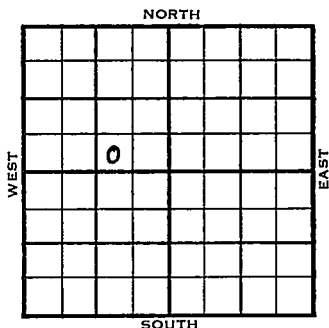

..

	ELEVATION	REPORT
1955	2520'	

1/12

Spud 1-5-55

8" @ 195'

Drlg. 2840'

2/16

Spud 1-5-55

Oil Well

TD 4474'

8" @ 195'

Anhy 1767', Heeb 3804' Lans 3857'

Cong. 4433', Miss 4456'

DST 4455'-64' opn 1 hr, rec 60' vso &amp; gcm 1130#

TD 4474'

5" @ 4473'

CO to 4470 12/ 4454-57 12/ 4459-62

500 A 4 boph 6% Wtr.

Comp 107 bopd.

**COMPLETED**



County Ness State Kansas

Sec. 26 (Blk. Twp.) 17 (Sur. Rge.) 25W Map No.

Operator Barnett Oil

Well No. 2 Farm Shearer "B"

Elev. 2520 Location SW SE NW


330 Ft. From S Line NW

990 Ft. From E Line Quarter

1st. Report

Completion FEB 16 1955

Remarks NE Aldrich Pool

Barnett - Contr.

Spudding Date 1-5-55

Drilg. Data Oil well TD 4474

8" @ 195 Anhy 1767 Heeb. 3804

Lans. 3857 Cong. 4433 Miss. 4456

DST 4455-64 open 1 hr. Rec. 60' vso &

gcm 1130# TD 4474 5" @ 4473

CO to 4470 12/ 4454-57 12/ 4459-62

500 A 4 boph 6% wtr. Comp. 107 bopd.

FABEN GILSTRAP