

FORM 51

Section 23 Township 13 Range 17W

Well No. 1 Dinkel

Company Alpine Oil & Royalty

NORTH

					0		

WEST

EAST

SOUTH

Sec. 23 Twp. 13 R. 17 W

Well No. # 1 Dinkel Farm

Alpine Oil & Royalty Company

Quaker Drlg. Contractor


Ft. from N. Line

990 Ft. from S. Line

Ft. from E. Line

990 Ft. from W. Line

NE SW NE

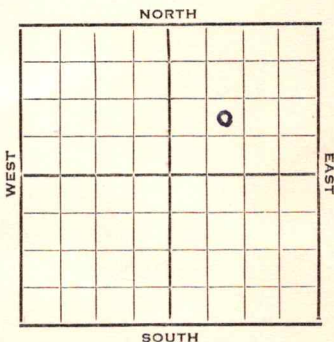

1953 **Elev. 1996'** REPORT

- 4/8 Cellar & Pits
- 4/16 8" @ 196
Drlg. 2700'
- 4/23 **Anhy 1175, Heeb 3225, Lans 3272,**
Cong 3521
RTD 3561
5" Set
- 4/30 5" set 3558'
- 5/7 NR
- 5/21 NR
- 5/28 N.R.
- 6/3 "
- 6/10 24/ 3430-34 SO 1000 A S/ 2 boph 6
hrs. WOP **Arb 3550'**
- 6/24 No report
- 7/1 "
- 7/8 "
- 7/22 "
- 7/29 "
- 8/5 "
- 8/19 "

OVER

1953

9/16

721637

Spud 4-7-53 Oil well TD 3561

8" @ 196 Anhy 1175 Heeb 3225

Lans 3272 Cong 3521 TD 3561

5" @ 3558

DST 3280-3306 open $\frac{1}{2}$ hr rec 8' SOCM
150#

DST 3330-57 open 1 hr rec 150' SO &
GCM, 120' HO & GCM, 30' oil, 30' wtr.
915#

DST 3412-32 open $\frac{3}{4}$ hr rec 10' VHOCM

Off 24/3430-34 1000 A S/2 BOPH

6 hr. Arb. 3550

Comp. 20 BOPD

COMPLETED

County Ellis State Kansas

Sec. 23 (Blk.) 13 (Sur.) 17W Map No.

Operator Alpine Oil & Royalty

Well No. 1 Farm Dinkel

Elev. 1996 Location NE SW NE

990 Ft. From S Line NE

990 Ft. From W Line Quarter

1st. Report

Completion SEP 16 1953

Remarks

Quaker Drlg. - Contr.

Spudding Date 4-7-53

COMPLETE

Drlg. Data Oil well TD 3561

8" @ 196 Anhy 1175 Heeb. 3225

Lans. 3272 Cong. 3521 TD 3561

5" @ 3558 DST 3280-3306 open 1/2 hr.

Rec. 8' socm 150# DST 3330-57

open 1 hr. Rec. 150' so & gcm 120' ho &

gcm 30' oil 30' wtr. 915#

DST 3412-32 open 3/4 hr. Rec. 10' whocm

O# 24/ 3430-34 1000 A S/ 2 boph 6 hr.

Arb. 3550 Comp. 20 bopd.