

KANSAS


FORM 51 25M 3-49 PETROLEUM

Barton

Section 16 Township 16S Range 12W

Well No. #1 Jarus

Company D. R. Lauck

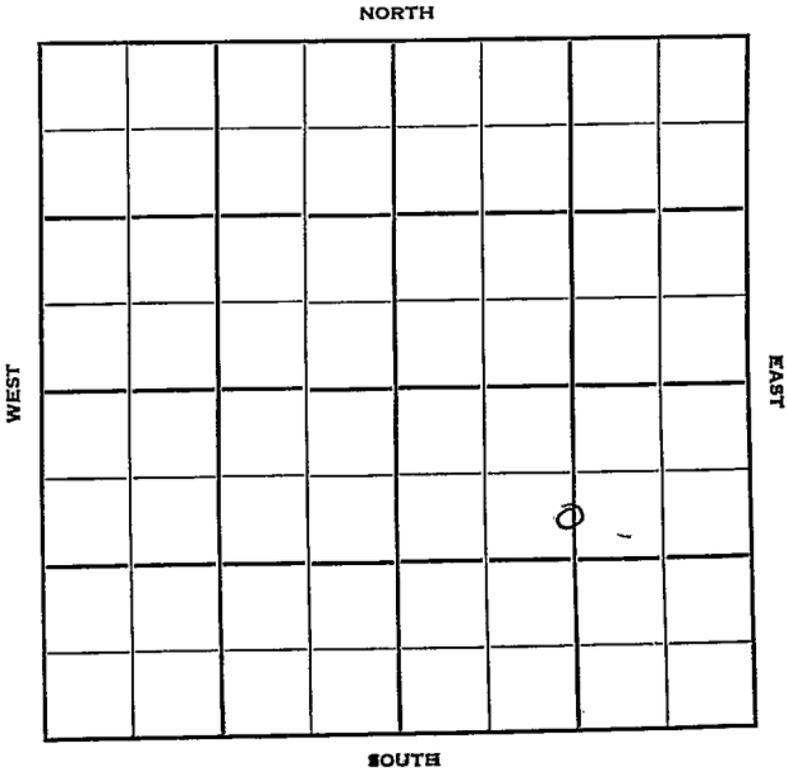

Sec. 16 Twp. 16 R. 12-W

Well No. #1 Jarus Farm _____

D R Lauck

Company _____

Cont D R Lauck

990

Kraft-Prusa
Ft. from N. Line


_____ Ft. from S. Line

1320

Ft. from E. Line

_____ Ft. from W. Line

C S $\frac{1}{2}$ N $\frac{1}{2}$ SE

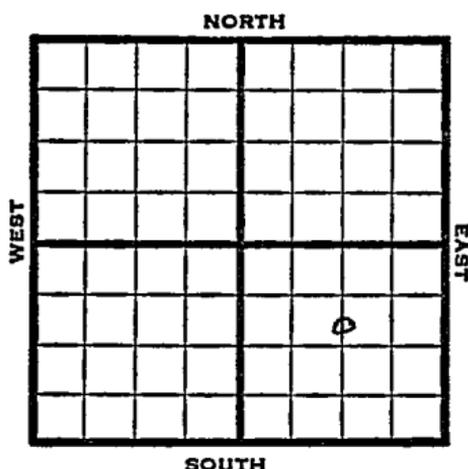

1949

Elev. 1890' REPORT

10/12

10" @ 280'

Anhy 795

Drlg 2135'

10/19

Lansing 3071'

Drlg 3290'

10/26

Arbuckle 3329'

5" @ 3329'

TD 3334'

11/2

TD 3334'

Arb. 3329'

5" @ 3329'

Pump 100 Oil Pot

42° Gr.

Comp

COMPLETED

Kansas

Map No. _____ Sec. 16 Twp. 16 R. 12W

Well No. 1 Jarus

D. R. Lauck _____ Company

D. R. Lauck _____ Contractor


C S $\frac{1}{2}$ N $\frac{1}{2}$ SEFIRST REPORT
SECTION PLAT

990 Ft. from N. Line

_____ Ft. from S. Line

1320 Ft. from E. Line

_____ Ft. from W. Line

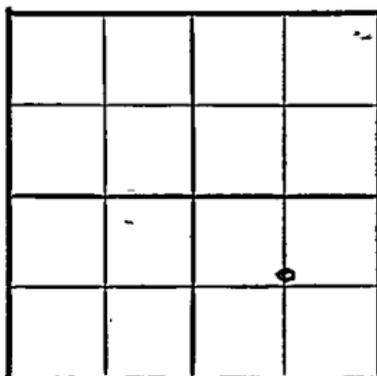

Barton County

Location _____

Rig up _____

Drilling and Remarks:

10" @ 280

Anhy 795

drlg. 2135

RECORD

Cased _____ in., _____ ft.

Sand _____

Gas _____

Oil _____

Total Depth _____

PRODUCTION

1st 24 hrs. Nat. _____

1st 24 hrs. after shot _____

Gas _____ Cu. Ft.

Dry Hole _____

Abandoned _____

Date

OCT 12 1949 19

S. J. LEWIS Scout

Kansas

Map No. _____ Sec. 16 Twp. 16 R. 12W

Well No. 1 Jarus

D. R. Lauck

Company

COMPLETE

Contractor


C S $\frac{1}{2}$ N $\frac{1}{2}$ SEE. 1880
SECTION PLAT

990 Ft. from N. Line

_____ Ft. from S. Line

1320 Ft. from E. Line

_____ Ft. from W. Line

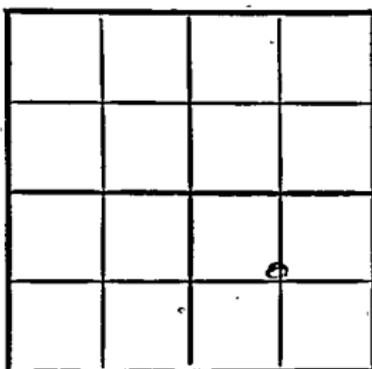

Barton County

RECORD

Location _____

Cased _____ in., _____ ft.

Rig up _____

Sand _____

Drilling and Remarks:

Gas _____

Oil _____

Total Depth 3394

PRODUCTION

1st 24 hrs. Nat. _____

1st 24 hrs. after shot _____

Gas _____ Cu. Ft.

Dry Hole _____

Abandoned _____

Date

NOV 2 1949 19

S. J. LEWIS

Scout

See 3329
5" C 3329
Pump 100 oil
42 R/L