


Map No. 16 Sec. 16 Twp. 16 R. 12 W

Well No. 3-Jarvis Farm

Darby Pit Company

NORTH

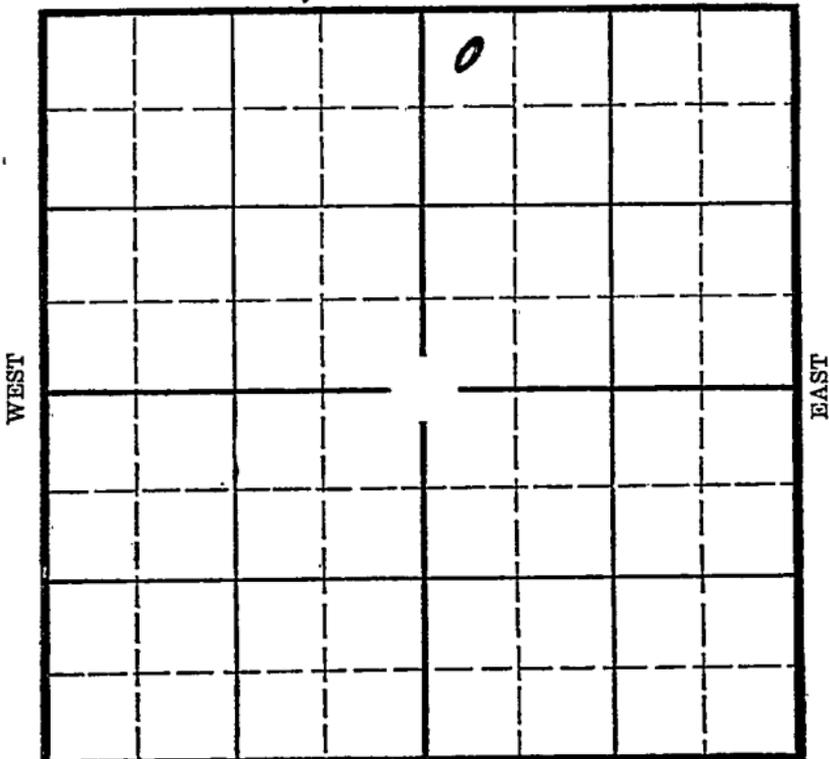

SOUTH

Location \_\_\_\_\_

Drilling Remarks \_\_\_\_\_

Rig Up \_\_\_\_\_

Drilling Remarks \_\_\_\_\_

RECORD

Cased \_\_\_\_\_ in. \_\_\_\_\_ ft.

Sand \_\_\_\_\_

Gas \_\_\_\_\_

Oil \_\_\_\_\_

Total Depth \_\_\_\_\_

PRODUCTION

1st 24 hrs. Nat. \_\_\_\_\_

1st 24 hrs. after shot \_\_\_\_\_

Gas \_\_\_\_\_ cu. ft. \_\_\_\_\_

Dry Hole \_\_\_\_\_

Abandoned \_\_\_\_\_

Barton

Map No. KANSAS Sec. 16 Twp. 16 R. 12<sup>w</sup>

Well No. 3- Jarvis Farm  
Darby Pit Company


NORTH

330 Ft. from N. Line

\_\_\_\_\_ Ft. from S. Line

\_\_\_\_\_ Ft. from E. Line

330 Ft. from W. Line

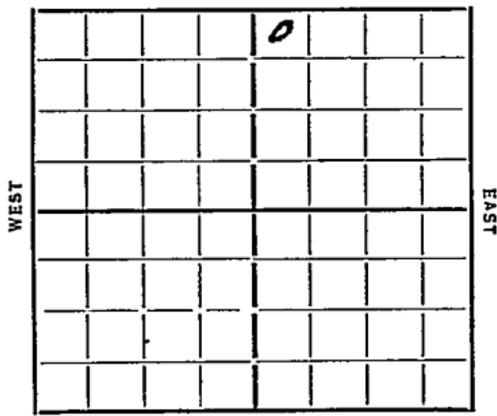

Elev. 1897

Date

REPORT

7/3/5  
 6/26 Location  
 7/3 Cellar  
 7/14 Rig  
 7/18 Spuds  
 8/8 dly 1850  
 8/15 w/c 10" 2205  
 8/22 dly 2875 Topeka 2705  
 8/29 Lansing 3078 403280-87  
 6" 3324 Cong 3334  
 dly 3339  
 9/4 lib 3363  
 T 3369  
 D. A.

ABANDONED

Map No. 55 Sec. 16 Twp. 16 R. 12W

Well No. 3 Jarvis

Dusty P. Co. Company

Contractor

SECTION PLAT

		0	

320 Ft. from N. Line

..... Ft. from S. Line

..... Ft. from E. Line

320 Ft. from W. Line

FIRST REPORTS

Location

Rig up.....

Drilling and Remarks:

RECORD

Cased..... in., ..... ft.

Sand.....

Gas.....

Oil.....

Total Depth.....

PRODUCTION

1st 24 hrs. Nat.....

1st 24 hrs. after shot.....

Gas..... Cu. Ft.

Dry Hole.....

Abandoned.....

Date

**ORVAL MANNSCHECK**

6/26/30 192.....

Scout

Map No. 55 Sec. 16 Twp. 16 R. 12W

Well No. 3 - Jarvis

Ducky Petroleum Company

Contractor

ABANDONED

SECTION PLAT

330 Ft. from N. Line

..... Ft. from S. Line

..... Ft. from E. Line

330 Ft. from W. Line

		0	

Location.....

Rig up.....

Drilling and Remarks:

10 ✓ FF

RECORD

Cased..... in. .... ft.

Sand 100 3363

Gas.....

Oil.....

Total Depth 3369

PRODUCTION

1st 24 hrs. Nat.....

1st 24 hrs. after shot.....

Gas..... Cu. Ft.

Dry Hole.....

Abandoned.....

Date

9-4-35 192.....

ORVAL MANNSCHRECK

Scout