
BARTON

FORM 51 5M 11-44 PETROL KANSAS

Section 16 Township 16 S Range 12 W

Well No. #1 Klutgel

Company MARTIN & HERING

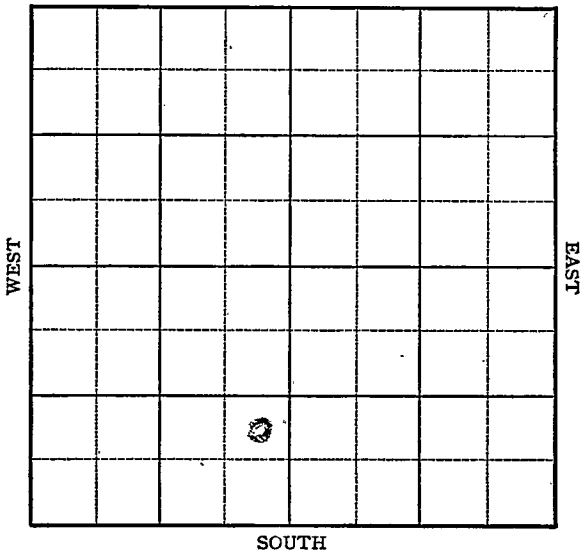

FORM 252 A
5M 3-45 PETRCL

KANSAS Barton County

Sec. 16 Twp. 16 R. 12W

Well No. #1 Klutgel Farm

Martin & Hering Company


Kraft-Prusa

____ Ft. from N. Line

990 Ft. from S. Line

330 Ft. from E. Line

____ Ft. from W. Line

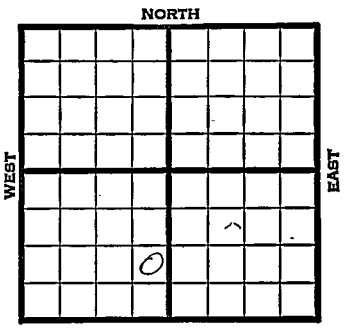

NE SE SW Elev. 1915

1945	REPORT
4/11	Location
4/20	Derrick
4/27	"
5/3	"
5/10	"
5/17	"
5/24	"
5/31	Drlg. 375
6/8	12" @ 510 Drlg. 550
6/14	Anhy 811
	Drlg. 1345'
6/21	10" @ 1022
	Drlg. 1990
6/28	8" @ 2122-2280 UR 8"
7/3	8" @ 2340
	Drlg. 2435
7/11	Drlg. 2590
	8" @ 2527
7/19	7" @ 2890'
	Drlg. 2925
	S Gas.
7/26	Lans 3070
	TD 3094
	7" @ 3087' RUST
8/1	TD 3101
	2000 acid
8/8	" "
8/15	" "
8/22	Pump 25 oil a day
8/29	" " "
9/5	" " " OVER

1945

9/12	Pump 25 oil a day
9/19	" " " "
9/26	" " " "
10/3	" " " "
10/10	" " " "
10/17	Lans 3072
	7" @ 3090
	2000 acid.
	TD 3101'
	Pump 10 oil plus 5 Wtr. Pot.
	Grav. 42.0

COMPLETED

FORM 25 200 BKS. 1 44 PETROL

Kansas Pool Name Kraft-Prusa

Map No. 55 Sec. 16 Twp. 16 R. 12W


Well No. 1 Klutgel

Martin & Hering Company

FIRST REPORT Contractor

NE SE SW

SECTION PLAT

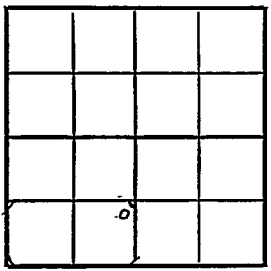

Ft. from N. Line

990 Ft. from S. Line

330 Ft. from E. Line

Ft. from W. Line

Barton

Location X

Rig up

Drilling and Remarks:

RECORD

Cased in., ft.

Sand

Gas

Oil

Total Depth

PRODUCTION

1st 24 hrs. Nat.

1st 24 hrs. after shot

Gas Cu. Ft.

Dry Hole

Abandoned

Date

APR 1 1 1945 19

S. J. LEWIS Scout

FORM 56 200 BKS, 1-44 PETROL

KANSAS Kansas Pool Name Kraft-Prusa

Map No. ~~S~~ Sec. 16 Twp. 16 R. 12W

Well No. 1 Klutgel


Martin and Hering Company

COMPLETED Contractor

NE SE SW

E 1915

SECTION PLAT

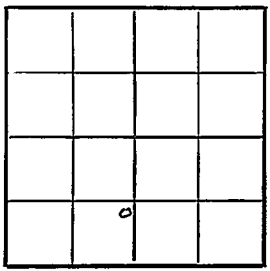

Ft. from N. Line

990 Ft. from S. Line

330 Ft. from E. Line

Ft. from W. Line

Barton County

Location

Rig up

Drilling and Remarks:

Lans 3072.
7" @ 3098
2000 Acid
Pump 10 oil + SW
BJ

42° Gr

RECORD

Cased in., ft.

Sand

Gas

Oil

Total Depth 3101

PRODUCTION

1st 24 hrs. Nat.

1st 24 hrs. after shot

Gas Cu. Ft.

Dry Hole

Abandoned

Date

OCT 17 1945 19

S. J. LEWIS Scout