


Section 23 Township 13 Range 17 W

Well No. # 5 Rome

Company Murfin Drlg.

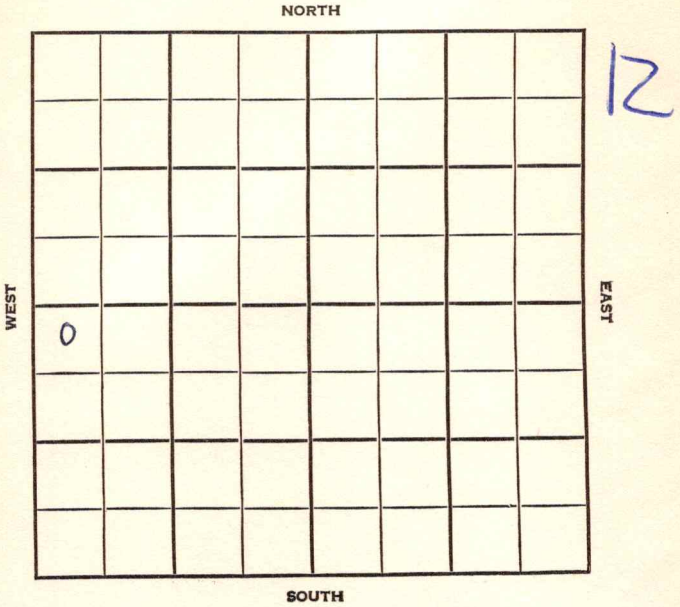


SEC. 23	TWP. 13	R. 17W
------------	------------	-----------

WELL NO. _____
 COMPANY #5 Rome FARM

CONTRACTOR Murfin Drlg.

Co. Tools.
 Sugarloaf Pool

330 _____ Ft. from N. Line
 _____ Ft. from S. Line
 _____ Ft. from E. Line
 330 _____ Ft. from W. Line

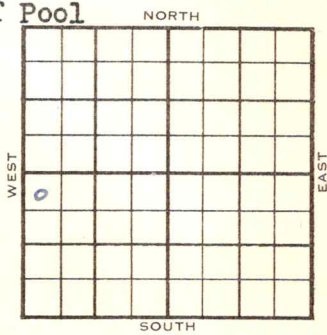

NW NW SW

Sinc. DHM

1954	ELEVATION 1964' DF	REPORT
------	-----------------------	--------

9/15
~~10/~~
 9/22

Spud 9-11-54
 8" @ 124'
 Drlg. 2581'

Spud 9-11-54 D & A TD 3652
 8" @ 124' Heeb 3235 Lans 3285
 Cong. 3526 TD 3652 D & A

ABANDONED

