

Ellis


KANSAS

SECTION 25 TOWNSHIP 13 RANGE 17W

WELL NO. #1 Dreiling

COMPANY Petroleum Inc.

NORTH

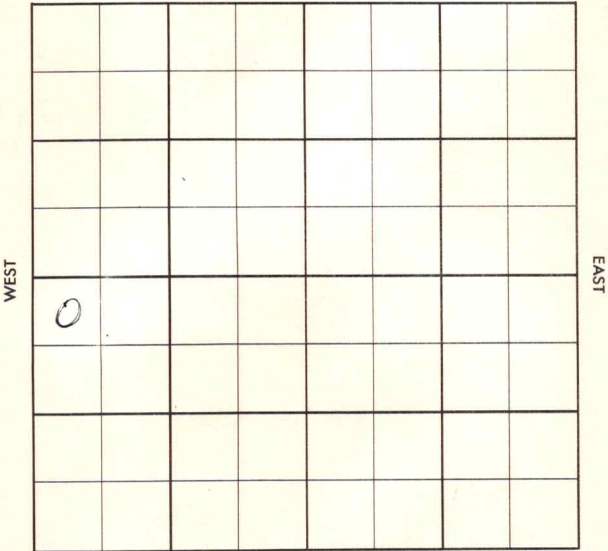

SOUTH

WEST

EAST

County Ellis Elev. 1986
 Sec. 25 Twp. 13 Rgs. 17W
 Company Petroleum Inc.
 Farm Name Dreiling No. 1

TOPS	DEPTH	LOG	DATUM	Loc. in Sec.
Anh.	1162			NW NW SW
TP.	2980			
H.	3230			
Tr.	3248			
Dg.				
BL.				
L.	3276			Geol.
K.C.				Contr.
B.K.C.	3461			
Ce.				Co. tools
C.	3526			
M.				Pool
M.				SE Sugarloaf
K.				
Mz.				
Ma.				
V.				<div style="border: 1px solid black; padding: 5px; text-align: center;"> ABANDONED JAN 16 '57 </div>
S.				
S.				
A.				
R.				
PE.				
G.				
T.D.	3603			

Date Comm. 12-31-56
8" @ 175/125 drlg. 2255 JAN 9 '57
DST 3287-3327 1hr 30' Md
(USSO) 140/30" DST 3338-78
1hr 30' WM BHP 950/30"
DST 3410-60 1hr 5' Md
BHP 0/30" JAN 16 '57

Dia (HHT)